

REMONI

STATE OF MICHIGAN
COUNTY OF KENT
RECEIVED FOR RECORD

94 AUG 24 AM 11:52

LAND CORNER RECORDATION CERTIFICATE
Filing Requirement of Act 74, Mich. P.A. 1970

For corners in

Kent
(County)

Located In:

Courtland Twp.
Corner Code 77

- | | | |
|------------------------------------|----------------------------|----------------------|
| 1. Public Land Survey | T <u>9</u> N R <u>10</u> W | <u>D-4</u> |
| | T ___ R ___ | <u>Center Sec. 8</u> |
| | T ___ R ___ | _____ |
| | T ___ R ___ | _____ |
| 2. Property Controlling in Section | S ___ T ___ R ___ | _____ |
| | S ___ T ___ R ___ | _____ |
| 3. Miscellaneous Property in Sec. | S ___ T ___ R ___ | _____ |
| | S ___ T ___ R ___ | _____ |

Luigi Bond
REG. OF DEEDS

6977

Register of Deeds Stamp & File Number

4. Lot No. _____, Recorded Plat _____
5. Private Claims _____

A	B	C	D	E	F	G	H	I	J	K	L	M
2	6	5	4	3	2	1						
3												
4	7	▲	9	10	11	12						
5												
6	18	17	16	15	14	13						
7												
8	19	20	21	22	23	24						
9												
10	30	29	28	27	26	25						
11												
12	31	32	33	34	35	36						
13												

I, Wallace E. Glaza in a field survey on August 2, 19 94, do hereby certify that under requirements of P.A. 74, Michigan P.A. of 1970, the corner points mentioned in lines 1 and 2 above were in conformance with regulations and rules therefore as required in the current manual of survey instructions of the United States Department of the Interior, Bureau of Land Management or by a decree of a Court of Law and/or that the corner points mentioned in lines 3, 4 and 5 above were in conformance with the rules of the Michigan Board of Land Surveyors or by a Decree of a Court of Law; established, re-established, monumented, re-monumented, recovered, found as expressed below:

NOTE: Not more than 4 corners, all in the same town and range, may be recorded on this certificate.

A. Description of original monument and accessories and/or subsequent restoration:

No previous history found on corner.

No other information available from the County Surveyor's Office, other surveying firms or any other sources.

B. Description of corner evidence found and/or method applied in restoring or reestablishing corner:

D-4 (Center of Section 8, T9N, R10W, Courtland Township, Kent County, Michigan)

Set standard 4" x 30" Kent County monument (Harrison) at the intersection of the 1/4 lines.

- West 1/4 corner to Center - 2650.78'
- North 1/4 corner to Center - 2644.34'
- East 1/4 corner to Center - 2654.94'
- South 1/4 corner to Center - 2669.48'


P.A. 345 1990 KENT COUNTY

PEER APPROVED 7/28/94
CHAIRMAN *Harry Huber*

C. Description of monument for corner and accessories established to perpetuate locating the position of the corner:

D-4 (4" x 30" Kent County Monument)

- | | | |
|---|-------|--------|
| 1) Remon tag & nail in SW side 36" twin Oak | S57°E | 46.98' |
| 2) Remon tag & nail in W. side 18" twin Oak | S19°E | 40.31' |
| 3) Remon tag & nail in SE side 12" Elm | S73°W | 18.14' |
| 4) Remon tag & nail in NW side 18" twin Oak | N74°E | 59.36' |

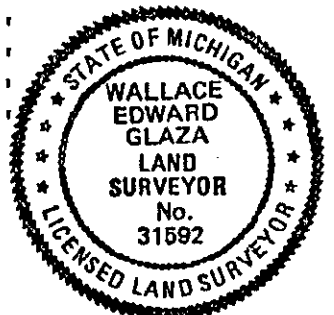

Signed by *Wallace E. Glaza*
Glaza and Associates, Inc.
Surveyor's Michigan License No. 31592

Date August 4, 1994