

MAY 22 2000

\$7.00
\$2.00

SECTION LAND CORNER RECORDATION CERTIFICATE
Filing Requirement of Act 74, Mich. P.A. 1970
KENT COUNTY REMONUMENTATION

For corners in

Kent (County)	Located in:	Courtland Township	Corner Code #
1. Public Land Survey	T	9N R 10W	D-6
	T	R	
	T	R	
	T	R	
2. Property Controlling in Section	S	T R	
	S	T R	
3. Miscellaneous Property in Sec.	S	T R	
	S	T R	

REG. OF DEEDS

[Signature]

STATE OF MICHIGAN
COUNTY OF KENT
RECEIVED FOR RECORD
1999 OCT 15 AM 8:04


11292

Register of Deeds Stamp & File Number

- 4. Lot No. _____, Recorded Plat _____
- 5. Private Claims _____

I, Randy Kolehouse, in a field survey on January 25 19 99, do hereby certify that under requirements of P.A. 74 Michigan P.A. of 1970, the corner points mentioned in lines 1 and 2 above were in conformance with regulations and rules therefore as required in the current manual of survey instructions of the United States Department of the interior, Bureau of Land Management or by a decree of a Court of Law and/or that the corner points mentioned in lines 3, 4 and 5 above were in conformance with the rules of the Michigan Board of Land Surveyors or by a Decree of a Court of Law; established, re-established, monumented, re-monumented, recovered, found as expressed below:

NOTE: Not more than 4 corners, all in the same town and range, may be recorded on this certificate.

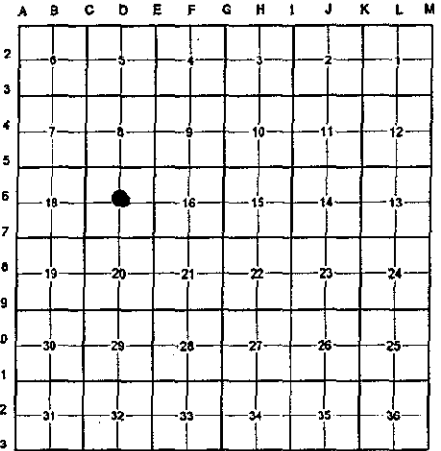

A. Description of original monument and accessories and/or subsequent restoration:

D-6 This corner was not originally set by the G.L.O.

1957	Survey Records	Russ Donker	Set Iron @ Int. of 1/4 Lines
1975	L.C.R.C. #880	Gordon Nederveld	3/4" Iron
1989	L.C.R.C. #5158	Thomas Chettleburgh	Fnd. 3/4" Iron Pipe / Set K.C. Monument

P.A. 345 KENT CO. COUNTY
PEER APPROVED 2/25/99
CHAIRMAN [Signature]

B. Description of corner evidence found and/or method applied in restoring or reestablishing corner:

D-6 Found a Standard Kent County Monument 4' West of the C/L of Tefft Avenue (gravel) running North and South, on line of a fence line running East and West, per L.C.R.C. #5158 as set by T. Chettleburgh in place of a 3/4" iron he found that was set by Russ Donker in 1957. Per L.C.R.C. #5158, the Kent County Monument is approximately 3.4' South of the intersection of 1/4 lines (meas. 4.0'). Accepted the Kent County Monument as the Center of Section.

L.C.R.C. #5158


- 18" Maple S79°E 53.70' (m. 53.76')
- Power Pole S73°E 37.57' (m. 37.73')
- 9" Twin Apple S16°W 78.37' (m. 78.65')
- C/L 30' gravel road running N-S is East 4'+/-

The selected location is accepted by me and is generally accepted by professional surveyors as the best available evidence of the position of the original corner.

C. Description of monument for corner and accessories established to perpetuate locating the position of the corner:

D-6 Standard Kent County Monument

- Nail & K.C. remon. tag on N side 20" Maple S 79° E 53.76'
- Nail & K.C. remon. tag on S side P. pole S 73° E 37.73'
- Nail & K.C. remon. tag on E side 10" twin Apple S 16° W 78.65'
- Nail & K.C. remon. tag on S side fence post N 90° W 16.99'
- Nail & K.C. remon. tag on N side 6" twin Apple N 75° W 31.49'
- C/L of gravel road running N-S, East 4'
- On fence line running E-W

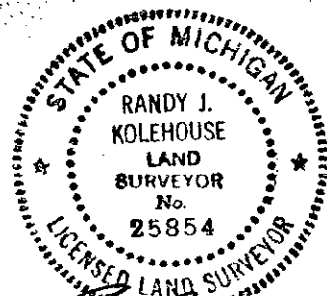

Signed by [Signature] Date _____

WILLIAMS & WORKS

Surveyor's Michigan License No. 25854