

MAY 22 2000

**LAND CORNER RECORDATION CERTIFICATE**  
Filing Requirement of Act 74, Mich. P.A. 1970  
KENT COUNTY REMONUMENTATION

STATE OF MICHIGAN  
COUNTY OF KENT  
RECEIVED FOR RECORD  
1999 OCT 15 AM 8:04

REG. OF DEEDS  
*[Signature]*

11293


Register of Deeds Stamp & File Number

For corners in

Kent (County)	Located in:	Courtland Township	Corner Code #
1. Public Land Survey	T <u>9N</u> R <u>10W</u>		<u>D-7</u>
	T _____ R _____		_____
	T _____ R _____		_____
	T _____ R _____		_____
2. Property Controlling in Section	S _____ T _____ R _____		_____
	S _____ T _____ R _____		_____
3. Miscellaneous Property in Sec.	S _____ T _____ R _____		_____
	S _____ T _____ R _____		_____

4. Lot No. \_\_\_\_\_, Recorded Plat \_\_\_\_\_  
5. Private Claims \_\_\_\_\_

I, Randy Kolehouse, in a field survey on January 8 19 99, do hereby certify that under requirements of P.A. 74 Michigan P.A. of 1970, the corner points mentioned in lines 1 and 2 above were in conformance with regulations and rules therefore as required in the current manual of survey instructions of the United States Department of the interior, Bureau of Land Management or by a decree of a Court of Law and/or that the corner points mentioned in lines 3, 4 and 5 above were in conformance with the rules of the Michigan Board of Land Surveyors or by a Decree of a Court of Law; established, re-established, monumented, re-monumented, recovered, found as expressed below:

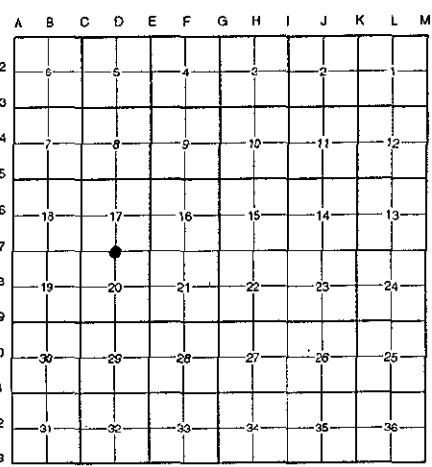

**NOTE: Not more than 4 corners, all in the same town and range, may be recorded on this certificate.**

A. Description of original monument and accessories and/or subsequent restoration:

D-7	1837	G.L.O. Notes	Cathcart	Set Post
	1963	Witness Map	K.C. Surveyor	Iron & Stone
	1975	L.C.R.C. #880	Medema, Van Kooten & Assoc.	"T" Iron in Mon. Box
	1982	L.C.R.C. #2982	Jonker Land Survey	Fnd. "T" Iron in Mon. Box / Set K.C. Mon. in Mon. Box
	1988	L.C.R.C. #4811	Olson, Meyer & May	K.C. Monument in Mon. Box

This corner was originally approved by the Kent County Remonumentation Peer Group and monumented by Rob Jonker on 7/7/82 and was recorded per L.C.R.C. #2982.

B. Description of corner evidence found and/or method applied in restoring or reestablishing corner:

D-7 Found a Standard Kent County Monument 3.0' South of the C/L intersection of 13 Mile Road (bit.) running East and West and Tefft Avenue (gravel) running North and 6.0' West of the C/L of Tefft Avenue (bit.) running South per L.C.R.C.'s #2982 and #4811 as set by Rob Jonker in place of a "T" iron he found in a monument box alongside a pointed stone 12" below grade which checked L.C.R.C. #880 and the K.C. Surveyor's records.

L.C.R.C. #2982

Remon. tag on N side p.pole S65°W 51.25'  
Remon. tag on SW side 8" Pine N45°W 93.46'  
NW cor. house fnd. S45°E 107.05'  
C/L E-W pvt. N 3'm/l  
On C/L gravel to N  
C/L E-W pavt  
On C/L gravel to N.

L.C.R.C. #4811

Remon. tag & nail on N sde P pole S 65 W 51.25' (m. 51.27')  
Remon. tag & nail on SW sde 10" Pine N 45 W 93.42' (m. 93.42')  
NW cor hse fndn S 45 E 107.05' (m. 106.98')  
C/L E-W pavt. N 3'M/L  
On C/L gravel to N

P.A. 345 1990 KENT COUNTY  
PEER APPROVED 2/25/99  
CHAIRMAN *[Signature]*

The selected location is accepted by me and is generally accepted by professional surveyors as the best available evidence of the position of the original corner.

C. Description of monument for corner and accessories established to perpetuate locating the position of the corner:

D-7 Standard Kent County Monument

Nail & K.C. remon. tag on N side P. pole S 65° W 51.27'  
Nail & K.C. remon. tag on SW side 10" Pine N 45° W 93.42'  
Nail & K.C. remon. tag on N side 10" Pine N 45° E 65.74'  
NW cor. hse. Fndn. S 45° E 106.98'

C/L "X" of roads running E-W-N, North 3.0'  
C/L of bit. road running S, East 6.0'

Signed by Randy J. Kolehouse Date 3/30/99  
EARTH TECH

Surveyor's Michigan License No. 25854

