

\$7.00  
\$2.00

KENT COUNTY REMONUMENTATION

JAN 24 1996

LAND CORNER RECORDATION CERTIFICATE  
COMMISSION Filing Requirement of Act 74, Mich. P.A. 1970

For corners in  
KENT COUNTY  
(County)

Located In:

Corner Code #

1. Public Land Survey	T	9N	R	10W	D-8
	T		R		
	T		R		
	T		R		
2. Property Controlling in Section	S		T		
	S		T		
3. Miscellaneous Property in Section	S		T		
	S		T		

STATE OF MICHIGAN  
COUNTY OF KENT  
RECEIVED FOR RECORD

95 SEP 14 PM 12:35

REG. OF DEEDS  
8707

Register of Deeds Stamp & File Number

- 4. Lot No. \_\_\_\_\_, Recorded Plat \_\_\_\_\_
- 5. Private Claims \_\_\_\_\_

A	B	C	D	E	F	G	H	I	J	K	L	M
2	6	5	4	3	2	1						
3												
4	7	6	9	10	11	12						
5												
6	18	17	16	15	14	13						
7												
8	19	20	21	22	23	24						
9												
10	30	29	28	27	26	25						
11												
12	31	32	33	34	35	36						
13												

I, Kirk Breitels, in a field survey on June 28, 1995,

do hereby certify that under requirements of P.A. 74, Michigan P.A. of 1970, the corner points mentioned in lines 1 and 2 above were in conformance with regulations and rules therefore as required in the current manual of survey instructions of the United States Department of the Interior, Bureau of Land Management or by a decree of a Court of Law and/or that the corner points mentioned in lines 3, 4 and 5 above were in conformance with the rules of the Michigan Board of Professional Surveyors or by a Decree of a Court of Law; established, re-established, monumented, re-monumented, recovered, found as expressed below:

NOTE: Not more than 4 corners, all in the same town and range, may be recorded on this certificate.

A. Description of original monument and accessories and/or subsequent restoration:

- D-8 1837 GLO Not Set
- 1975 Survey Ed Glaza "Center"
- 1985 Survey Fricke Int. 1/4 lines
- 1992 Survey Hackbardt Int. 1/4 lines
- 1994 Survey Roosien Int. 1/4 lines per computations of information

P.A. 345 1990 KENT COUNTY

PEER APPROVED

CHAIRMAN

*B. 12/24/95*  
*Harry Hubert*

B. Description of corner evidence found and/or method applied in restoring or reestablishing corner:


D-8 Found Capped Rerod (All Points) 0.1' E. & 0.5' N. of true intersection of 1/4 lines and 5'± North of fence to West. Found Iron Pipe on fence line to West 4.3' South and 0.7' East of true intersection of 1/4 lines. Information on surveys by Fricke, Hackbardt & Roosien all agree with each other for use of true intersection of 1/4 lines. Information on Ed Glaza survey does not fit either of the Irons found.

The Intersection of 1/4 lines is accepted by me and is generally accepted by professional surveyors as the best available evidence of the position of the corner.

C. Description of monument for corner and accessories established to perpetuate locating the position of the corner:

D-8 Set Standard Kent County Monument at the intersection of 1/4 lines.

- Capped Rerod (All Points) N20°W 0.48'
- Iron Pipe S00°W 4.36'
- Set Nail & KC Remon. tag E. side 48" Maple S25°W 5.70'
- Set Nail & KC Remon. tag E. side 15" Maple N05°W 27.51'
- Set Nail & KC Remon. tag N. side P. Pole S80°E 58.89'
- Set Nail & KC Remon. tag S. side 28" Oak N70°W 58.53'
- C/L gravel road N-S is 22'± East; Fence to West is 5'± South

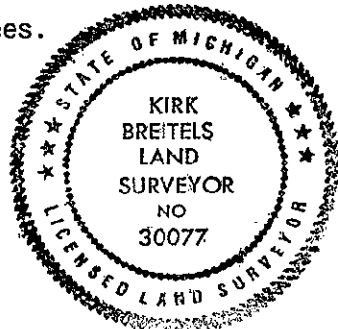

Signed by Kirk Breitels

Date 9/8/95

Surveyor's Michigan License No. 30077