

MAY 22 2000

\$7.00  
\$2.00

SECTION

LAND CORNER RECORDATION CERTIFICATE  
Filing Requirement of Act 74, Mich. P.A. 1970  
KENT COUNTY REMONUMENTATION

For corners in

Kent (County)	Located in: Courtland Township	Corner Code #
1. Public Land Survey	T <u>9N</u> R <u>10W</u>	<u>D-9</u>
	T _____ R _____	_____
	T _____ R _____	_____
	T _____ R _____	_____
2. Property Controlling in Section	S _____ T _____ R _____	_____
	S _____ T _____ R _____	_____
3. Miscellaneous Property in Sec.	S _____ T _____ R _____	_____
	S _____ T _____ R _____	_____

REG. OF DEEDS

*[Signature]*


STATE OF MICHIGAN  
COUNTY OF KENT  
RECEIVED FOR RECORD  
1999 OCT 15 AM 8:04

11294

Register of Deeds Stamp & File Number

- 4. Lot No. \_\_\_\_\_, Recorded Plat \_\_\_\_\_
- 5. Private Claims \_\_\_\_\_

I, Randy Kolehouse, in a field survey on January 7 19 99, do hereby certify that under requirements of P.A. 74 Michigan P.A. of 1970, the corner points mentioned in lines 1 and 2 above were in conformance with regulations and rules therefore as required in the current manual of survey instructions of the United States Department of the interior, Bureau of Land Management or by a decree of a Court of Law and/or that the corner points mentioned in lines 3, 4 and 5 above were in conformance with the rules of the Michigan Board of Land Surveyors or by a Decree of a Court of Law; established, re-established, monumented, re-monumented, recovered, found as expressed below:

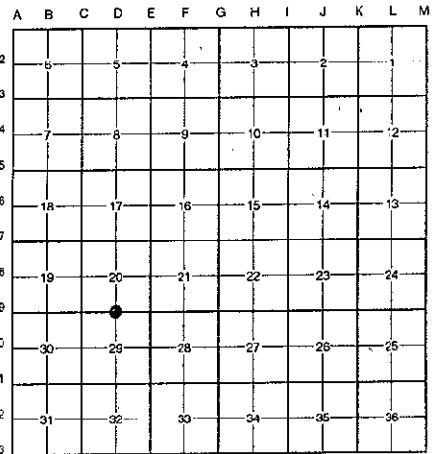

NOTE: Not more than 4 corners, all in the same town and range, may be recorded on this certificate.

A. Description of original monument and accessories and/or subsequent restoration:

D-9	1837	G.L.O. Notes	Cathcart	Set Post	P.A. 345 1990 KENT COUNTY
	1972	L.C.R.C. #211	Exxel Engineering	3/4" Iron Pipe	PEER APPROVED 2/25/99
	1973	L.C.R.C. #584	Williams & Works	1-1/2" Iron	CHAIRMAN <i>[Signature]</i>
	1982	L.C.R.C. #2984	Jonker Land Survey	Fnd. 3/4" Capped Iron / Set K.C. Monument	
	1988	L.C.R.C. #4812	John Bueche	K.C. Monument	

This corner was originally approved by the Kent County Remonumentation Peer Group and monumented by Rob Jonker on 7/8/82 and was recorded per L.C.R.C. #2984.

B. Description of corner evidence found and/or method applied in restoring or reestablishing corner:

- D-9 Found a Standard Kent County Monument 7.0' East of the C/L intersection of Tefft Avenue (gravel) running North and 12 Mile Road (bit.) running East and West, on line of a tree row running South, per L.C.R.C.'s #2984 and #4812 as set by Rob Jonker in place of a 3/4" capped iron he found which checked L.C.R.C.'s #584 and #211.

L.C.R.C. #2984

L.C.R.C. #4812

Remon. tag on NW side p.pole N60°E 56.16'  
 Remon. tag on NE side 36" Maple S60°E 68.46'  
 Remon. tag on W side 34" Pignut S05°W 39.05'  
 C/L gravel to N is 7'W.m/l  
 On C/L E-W pavement  
 On tree line to S.

Remon tag & nail on NW sde P pole N 60 E 56.16' (m. 56.20')  
 Remon tag & nail on NW sde 38" Maple S 60 E 68.46' (m. 68.43')  
 Remon tag & nail on W sde 36" Pignut S 5 W 39.05' (m. 39.20')  
 Remon tag & nail in S sde fence post N 45 W 51.22' (m. 52.30')  
 "X" cut in top C/L W end 12" conc culvt. S 70 W 50.98' (m. 51.02')  
 C/L gravel to N is 7' W M/L  
 On C/L E-W pavt.  
 On tree line to S

The selected location is accepted by me and is generally accepted by professional surveyors as the best available evidence of the position of the original corner.

C. Description of monument for corner and accessories established to perpetuate locating the position of the corner:

D-9 Standard Kent County Monument

Nail & K.C. remon. tag on NW side P. pole N 60° E 56.20'  
 Nail & K.C. remon. tag on NE side 40" Maple S 60° E 68.43'  
 Nail & K.C. remon. tag on W side 36" Pignut Hickory S 05° W 39.20'  
 Nail & K.C. remon. tag on S side fence post N 45° W 52.30'  
 NE cor. hse. S 40° W 134.35'  
 "X" cut West end 12" conc. culvert S 70° W 51.02'

C/L of bit. road running E-W  
 C/L of gravel road running North, West 7.0'  
 On tree row running S

Signed by Randy J. Kolehouse

EARTH TECH

Date 3/30/99

Surveyor's Michigan License No. 25854

