

**SURVEY &
REMONUMENTATION**

MAY 22 2000

SECTION

LAND CORNER RECORDATION CERTIFICATE
Filing Requirement of Act 74, Mich. P.A. 1970
KENT COUNTY REMONUMENTATION

For corners in


<u>Kent</u> (County)	Located in: Courtland Township	Corner Code #	
1. Public Land Survey	T <u>9N</u> R <u>10W</u>	<u>D-10</u>	
	T _____ R _____	_____	_____
	T _____ R _____	_____	_____
	T _____ R _____	_____	_____
2. Property Controlling in Section	S _____ T _____ R _____	_____	_____
	S _____ T _____ R _____	_____	_____
3. Miscellaneous Property in Sec.	S _____ T _____ R _____	_____	_____
	S _____ T _____ R _____	_____	_____

STATE OF MICHIGAN
 COUNTY OF KENT
 RECEIVED FOR RECORD
 1999 OCT 15 AM 8:04
 REG. OF DEEDS

11295

Register of Deeds Stamp & File Number

4. Lot No. _____, Recorded Plat _____
 5. Private Claims _____

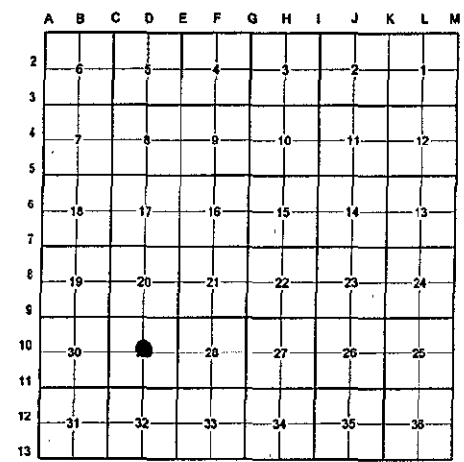

I, Randy Kolehouse, in a field survey on July 12, 1999 19 99, do hereby certify that under requirements of P.A. 74 Michigan P.A. of 1970, the corner points mentioned in lines 1 and 2 above were in conformance with regulations and rules therefore as required in the current manual of survey instructions of the United States Department of the Interior, Bureau of Land Management or by a decree of a Court of Law and/or that the corner points mentioned in lines 3, 4 and 5 above were in conformance with the rules of the Michigan Board of Land Surveyors or by a Decree of a Court of Law; established, re-established, monumented, remonumented, recovered, found as expressed below:

NOTE: Not more than 4 corners, all in the same town and range, may be recorded on this certificate.

A. Description of original monument and accessories and/or subsequent restoration:

D-10 This corner was not originally set by the G.L.O.
 No information on record.

B. Description of corner evidence found and/or method applied in restoring or reestablishing corner:


D-10 Set a point at the intersection of 1/4 lines. This point is 13' West and 8.3' South from corner of fences running North-South and East-West. Also found capped iron N 40° W 0.3' from point set at the intersection of 1/4 lines. Accepted intersection as Center of Section.

P.A. 345 1990 KENT COUNTY
 PEER APPROVED 2/25/99
 CHAIRMAN Harry Huber

The selected location is accepted by me and is generally accepted by professional surveyors as the best available evidence of the position of the original corner.

C. Description of monument for corner and accessories established to perpetuate locating the position of the corner:

D-10 Set a Standard Kent County Monument
 Nail & K.C. remon. tag on SW face 18" Maple N 55° W 33.20'
 Nail & K.C. remon. tag on W face 24" Hickory S 00° E 28.47'
 Nail & K.C. remon. tag on S face 10" Hickory S 75° E 29.86'
 Nail & K.C. remon. tag on W face 18" Oak N 20° E 32.45'
 Iron (17639 BW) N 40° W 0.3'
 On fence line running N-S & E-W

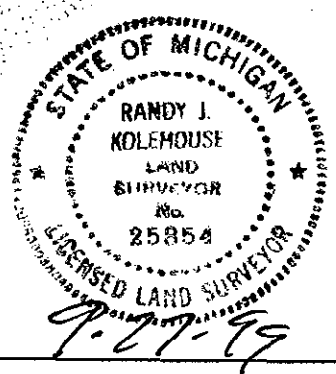

Signed by Randy Kolehouse Date _____
 WILLIAMS & WORKS

Surveyor's Michigan License No. 25854