

MAY 22 2000

SECTION

LAND CORNER RECORDATION CERTIFICATE
Filing Requirement of Act 74, Mich. P.A. 1970
KENT COUNTY REMONUMENTATION

For corners in

Table with columns: Kent (County), Located in: Courtland Township, Corner Code #. Rows include Public Land Survey, Property Controlling in Section, Miscellaneous Property in Sec.

REG. OF DEEDS

STATE OF MICHIGAN
COUNTY OF KENT
RECEIVED FOR RECORD
1999 OCT 15 AM 8:04

11296

Register of Deeds Stamp & File Number

- 4. Lot No. , Recorded Plat
5. Private Claims

I, Randy Kolehouse, in a field survey on January 5 19 99, do hereby certify that under requirements of P.A. 74 Michigan P.A. of 1970, the corner points mentioned in lines 1 and 2 above were in conformance with regulations and rules therefore as required in the current manual of survey instructions of the United States Department of the Interior, Bureau of Land Management or by a decree of a Court of Law and/or that the corner points mentioned in lines 3, 4 and 5 above were in conformance with the rules of the Michigan Board of Land Surveyors or by a Decree of a Court of Law, established, re-established, monumented, re-monumented, recovered, found as expressed below:

NOTE: Not more than 4 corners, all in the same town and range, may be recorded on this certificate.

A. Description of original monument and accessories and/or subsequent restoration:

Table with columns: D-11, 1837, 1942, 1990, G.L.O. Notes, Witness Map, L.C.R.C. #5321, Cathcart, K.C. Surveyor, J. Reda, Set Post, Monument in Mon. Box, 1-1/4" Iron in Mon. Box

Note: This corner has not been previously approved by the Kent County Remonumentation Peer Group and to date no monument had been set.

B. Description of corner evidence found and/or method applied in restoring or reestablishing corner:

D-11 Found a 1-1/4" iron in a monument box on the C/L of 11 Mile Road (bit.) running East and West, on line of a tree row running North and South, per L.C.R.C. #5321 and the K.C. Surveyor's records. Replaced iron with a Standard K.C. Monument using witnesses from L.C.R.C. #5321.

K.C. Witness Map (1942)

L.C.R.C. #5321

10" Oak SE 98.0' (m. 98.12' C/L)
C.P. pole NNW 37.7' (m. 38.09' C/L)

P.K. in N.E. sde 34" Oak S 60° E 98.0' (m. 98.12')
P.K. in N.E. sde 24" Oak S 40° E 79.9' (m. 82.28')
P.K. in W. sde C.P.Co. Pole N 10° W 38.0' (m. 38.09')

P.A. 345 1990 KENT COUNTY

PEER APPROVED 2/25/99


CHAIRMAN

The selected location is accepted by me and is generally accepted by professional surveyors as the best available evidence of the position of the original corner.

C. Description of monument for corner and accessories established to perpetuate locating the position of the corner:

D-11 Replaced Iron with a Standard Kent County Monument

- Nail & K.C. remon. tag on W side Consumers Power Co. pole N 10° W 38.00'
Nail & K.C. remon. tag on E side 15" Hickory South 67.00'
Nail & K.C. remon. tag on N side 34" Oak S 60° E 98.12'
Nail & K.C. remon. tag on N side 26" Oak S 40° E 82.28'
C/L of bit. road running E-W
On tree row running N-S

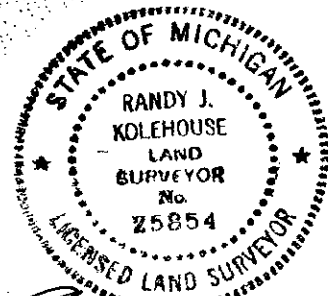

Signed by Randy J. Kolehouse
WILLIAMS & WORKS

Date 9-27-99

Surveyor's Michigan License No. 25854