SURVEY & REMONUMENTATION

OCT 28 1994

COMMISSION

STATE OF MICHIGAN
COUNTY OF KENT
RECEIVED FOR RECORD
94 AUG 24 AM 11:52
REG. OF DEEDS

LAND CORNER RECORDATION CERTIFICATE

Filing Requirement of Act 74, Mich. P.A. 1970

For corners in Kent (County) Located In: Courtland Twp. Corner Code #: D-12

1. Public Land Survey T 9N R 10W — Center Sec. 32
2. Property Controlling in Section
3. Miscellaneous Property in Sec.

6973
Register of Deeds Stamp & File Number

4. Lot No. _____, Recorded Plat _____
5. Private Claims _____

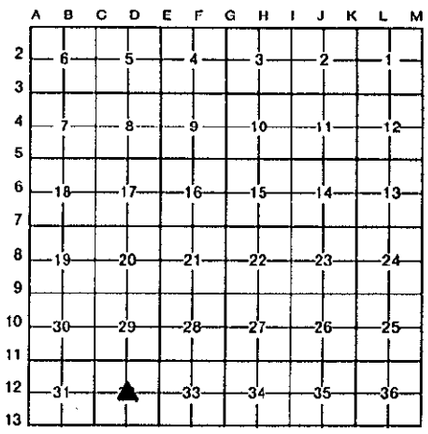

I, Wallace E. Glaza in a field survey on August 2, 1994, do hereby certify that under requirements of P.A. 74, Michigan P.A. of 1970, the corner points mentioned in lines 1 and 2 above were in conformance with regulations and rules therefore as required in the current manual of survey instructions of the United States Department of the Interior, Bureau of Land Management or by a decree of a Court of Law and/or that the corner points mentioned in lines 3, 4 and 5 above were in conformance with the rules of the Michigan Board of Land Surveyors or by a Decree of a Court of Law; established, re-established, monumented, re-monumented, recovered, found as expressed below:

NOTE: Not more than 4 corners, all in the same town and range, may be recorded on this certificate.

A. Description of original monument and accessories and/or subsequent restoration:

No previous history found on corner.

No other information available from the County Surveyor's Office, other surveying firms or any other sources.

B. Description of corner evidence found and/or method applied in restoring or reestablishing corner:

D-12 (Center of Section 32, T9N, R10W, Courtland Township, Kent County, Mich.)

Set standard 4" x 30" Kent County monument (Harrison) at the intersection of the ¼ lines.

West ¼ corner to Center - 2666.23'
North ¼ corner to Center - 2655.40'
East ¼ corner to Center - 2658.13'
South ¼ corner to Center - 2657.00'

P.A. 345 1990 KENT COUNTY
PEER APPROVED 7/28/94
CHAIRMAN Harry Huberc

C. Description of monument for corner and accessories established to perpetuate locating the position of the corner:

D-12 (4" x 30" Kent County monument)

1) Remon tag & nail in E. side 10" Hickory	N00°E	16.26'
2) Remon tag & nail in N. side 32" Oak	N90°E	38.18'
3) Remon tag & nail in W. side 14" Hickory	S00°W	13.45'
4) Remon tag & nail in N. side 8" Oak	S90°W	33.01'
5) Fence to West	South	0.2'
6) Fence to South	East	1.3'
7) Remnents of fence to East on line ±		

STATE OF MICHIGAN
WALLACE EDWARD GLAZA
LAND SURVEYOR
No. 31592
LICENSED LAND SURVEYOR

Signed by Wallace E. Glaza Date August 4, 1994
Galza and Associates, Inc.
Surveyor's Michigan License No. 31592

FORM APPROVED BY MICHIGAN STATE BOARD OF LAND SURVEYORS, JAN. 28, 1971
REVISED MAY 14, 1975
REVISED JAN., 1983