

SURVEY & REMONUMENTATION

MAR 03 1998

\$7.00
\$2.00

LAND CORNER RECORDATION CERTIFICATE
Filing Requirement of Act 74, Mich. P.A. 1970
KENT COUNTY REMONUMENTATION

SECTION

For corners in

<u>Kent</u> (County)	Located in: Courtland Township	Corner Code #
1. Public Land Survey	T <u>9N</u> R <u>10W</u>	<u>D-13</u>
	T _____ R _____	_____
	T _____ R _____	_____
	T _____ R _____	_____
2. Property Controlling in Section	S _____ T _____ R _____	_____
	S _____ T _____ R _____	_____
3. Miscellaneous Property in Sec.	S _____ T _____ R _____	_____
	S _____ T _____ R _____	_____
4. Lot No. _____, Recorded Plat _____		
5. Private Claims _____		

STATE OF MICHIGAN
COUNTY OF KENT
RECEIVED FOR RECORD
97 NOV 14 AM 9:01
REG. OF DEEDS
Luci Sand

10321


Register of Deeds Stamp & File Number

I, Randy Kolehouse, in a field survey on July 14 19 97, do hereby certify that under requirements of P.A. 74 Michigan P.A. of 1970, the corner points mentioned in lines 1 and 2 above were in conformance with regulations and rules therefore as required in the current manual of survey instructions of the United States Department of the interior, Bureau of Land Management or by a decree of a Court of Law and/or that the corner points mentioned in lines 3, 4 and 5 above were in conformance with the rules of the Michigan Board of Land Surveyors or by a Decree of a Court of Law; established, re-established, monumented, re-monumented, recovered, found as expressed below:

NOTE: Not more than 4 corners, all in the same town and range, may be recorded on this certificate.

A. Description of original monument and accessories and/or subsequent restoration:

D-13	1831	G.L.O. Notes	Mullett	Set Post
	N/A	Witness Map	K.C. Surveyor	Iron
	1954-66	Notes	Williams & Works	Iron
	1984	L.C.R.C. #3988	William Byl	Fnd. 1" Iron Pipe / Set K.C. Monument
	1988	L.C.R.C. #4813	J. Bueche	K.C. Monument

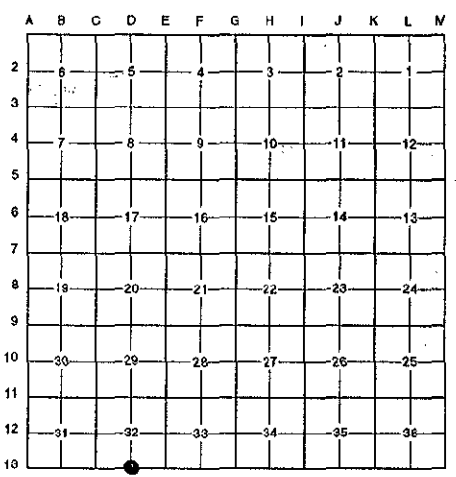

Note: This corner is not common with D-1, T8N, R10W.

This corner was originally approved by the Kent County Remonumentation Peer Group and monumented by William Byl on 10/15/84 and was recorded per L.C.R.C. #3988.

P.A. 345 1990 KENT COUNTY
PEER APPROVED 7/24/97
CHAIRMAN *William Byl*

B. Description of corner evidence found and/or method applied in restoring or reestablishing corner:


D-13 Found a Standard Kent County Monument 650' ± South of the C/L of 10 Mile Road (bit.) running East and West on line of a fence line and tree row running North per L.C.R.C.'s #3988 and #4813 as set by William Byl in place of a 1" iron pipe he found which checked the 1954-1966 notes of William & Works and the K.C. Surveyor's records.

L.C.R.C. #3988	L.C.R.C. #4813
Nail & tag, E. sd. 6" Oak N 25 E 29.83'	Nail & tag E sde 8" Oak N 25 E 29.83'
Nail & tag, S. sd. 20" Oak S 90 W 18.75'	Nail & tag S sde 22" Oak S 90 W 18.75'
Nail & tag, N. sd. 30" Oak S 65 E 9.22'	Nail & tag N sde 32" Oak S 65 E 9.22'
	Remon. tag & nail in E sde 4" Oak N 04 W 19.59' (m. 19.62')

The selected location is accepted by me and is generally accepted by professional surveyors as the best available evidence of the position of the original corner.

C. Description of monument for corner and accessories established to perpetuate locating the position of the corner:

- D-13. Standard Kent County Monument
- Nail & K.C. remon. tag on E side 10" Oak N 25° E 29.83'
 - Nail & K.C. remon. tag on S side 22" Oak S 90° W 18.75'
 - Nail & K.C. remon. tag on N side 32" Oak S 65° E 9.22'
 - Nail & K.C. remon. tag on E side 4" Oak N 04° W 19.62'
 - K.C. Mon., D-1, T8N, R10W, East 163.88'

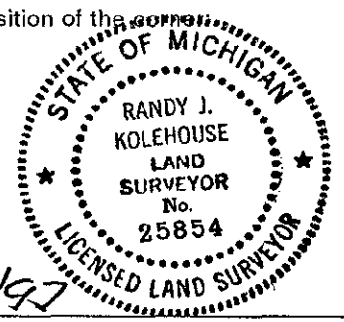

Signed by Randy J. Kolehouse
EARTH TECH

Date 7/23/97

Surveyor's Michigan License No. 25854