

MAY 22 2000

\$7.00  
\$2.00

SECTION

LAND CORNER RECORDATION CERTIFICATE  
Filing Requirement of Act 74, Mich. P.A. 1970  
KENT COUNTY REMONUMENTATION

For corners in

Kent (County)	Located in: Courtland Township	Corner Code #
1. Public Land Survey	T <u>9N</u> R <u>10W</u>	<u>E-1</u>
	T _____ R _____	_____
	T _____ R _____	_____
	T _____ R _____	_____
2. Property Controlling in Section	S _____ T _____ R _____	_____
	S _____ T _____ R _____	_____
3. Miscellaneous Property in Sec.	S _____ T _____ R _____	_____
	S _____ T _____ R _____	_____

REG. OF DEEDS

*[Signature]*

STATE OF MICHIGAN  
COUNTY OF KENT  
RECEIVED FOR RECORD  
1999 OCT 15 AM 8:04


11297

Register of Deeds Stamp & File Number

- 4. Lot No. \_\_\_\_\_, Recorded Plat \_\_\_\_\_
- 5. Private Claims \_\_\_\_\_

I, Randy Kolehouse, in a field survey on January 26 19 99, do hereby certify that under requirements of P.A. 74 Michigan P.A. of 1970, the corner points mentioned in lines 1 and 2 above were in conformance with regulations and rules therefore as required in the current manual of survey instructions of the United States Department of the interior, Bureau of Land Management or by a decree of a Court of Law and/or that the corner points mentioned in lines 3, 4 and 5 above were in conformance with the rules of the Michigan Board of Land Surveyors or by a Decree of a Court of Law; established, re-established, monumented, re-monumented, recovered, found as expressed below:

**NOTE:** Not more than 4 corners, all in the same town and range, may be recorded on this certificate.

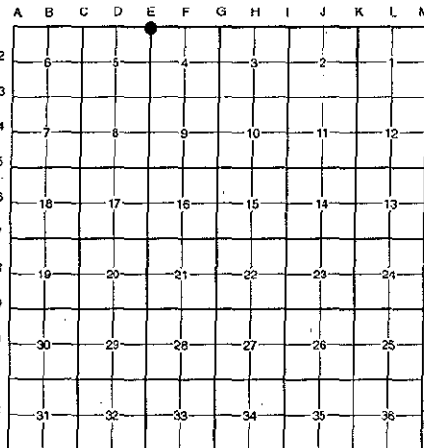

A. Description of original monument and accessories and/or subsequent restoration:

E-1	1837	G.L.O. Notes	Cathcart	Set Post
	1979	L.C.R.C. #1278	G. Hackbardt	1" Iron
	1986	L.C.R.C. #4435	R. Kolehouse	Fnd. 1" Iron / Set K.C. Monument
	1993	L.C.R.C. #6660	John Bueche	K.C. Monument

Note: This corner is not common with E-13, T10N, R10W.

This corner was originally approved by the Kent County Remonumentation Peer Group and monumented by Randy Kolehouse in May of 1986 and was recorded per L.C.R.C. #4435.

B. Description of corner evidence found and/or method applied in restoring or reestablishing corner:

E-1 Found a Standard Kent County Monument (broken) 3.0' South of the C/L of 16 Mile Road (bit.) running West and (gravel) running East) per L.C.R.C.'s #4435 and #6660 as set by Randy Kolehouse in place of a 1" iron he found on the Township line which checked L.C.R.C. #1278.

L.C.R.C. #4435

L.C.R.C. #6660

Nail & K.C. Remon. tag in N. side 16" Maple S 65° E 62.99'  
Nail & K.C. Remon. tag in S. side 6" Ash N 55° E 50.52'  
PK in SW side 14" Cedar N 40° W 103.54'  
K.C. Mon. at SE cor. section. 32 T10N R10W. West 47.55'

PK in SW side 20" Cedar N 40° W 103.54' (m. 103.52')  
PK in S side 8" Ash N 55° E 50.49' (m. 50.51')  
PK in N side 16" Maple S 65° E 62.98'  
Nail & K.C. Remon. Tag in W side dbl. 14" Maple S 10° E 79.17' (m. 79.13')  
SE cor. brick hse. S 55° W 160.23' (m. 160.28')  
K.C. Mon. (SE 32, 10-10) West 47.61'  
C/L bit. N-S, West 33'+/-  
C/L bit.-gravel E-W, N 3.5'+/-

The selected location is accepted by me and is generally accepted by professional surveyors as the best available evidence of the position of the original corner.

C. Description of monument for corner and accessories established to perpetuate locating the position of the corner:

E-1 Replaced Standard Kent County Monument

Nail & K.C. remon. tag on SW side 20" Cedar N 40° W 103.52'  
Nail & K.C. remon. tag on S side 10" Ash N 55° E 50.51'  
Nail & K.C. remon. tag on N side 16" Maple S 65° E 62.98'  
Nail & K.C. remon. tag on W side twin 14" Maple S 10° E 79.13'  
SE cor. brick hse. S 55° W 160.28'

C/L of bit. and gravel road running E-W, North 3.0'  
K.C. Mon. E-13 T10N R10W West 47.61'

P.A. 345 1990 KENT COUNTY

PEER APPROVED 2/23/99  
CHAIRMAN *[Signature]*

Signed by *[Signature]*

EARTH TECH

Date 3/30/99

Surveyor's Michigan License No. 25854

