

MAY 22 2000

SECTION

\$7.00
\$2.00

LAND CORNER RECORDATION CERTIFICATE
Filing Requirement of Act 74, Mich. P.A. 1970
KENT COUNTY REMONUMENTATION

REG. OF DEEDS

[Signature]

STATE OF MICHIGAN
COUNTY OF KENT
RECEIVED FOR RECORD
1999 OCT 15 AM 8:04

For corners in

Kent (County)	Located in: Courtland Township	Corner Code #
1. Public Land Survey	T <u>9N</u> R <u>10W</u>	<u>E2</u>
	T _____ R _____	_____
	T _____ R _____	_____
	T _____ R _____	_____
2. Property Controlling in Section	S _____ T _____ R _____	_____
	S _____ T _____ R _____	_____
3. Miscellaneous Property in Sec.	S _____ T _____ R _____	_____
	S _____ T _____ R _____	_____


11298

Register of Deeds Stamp & File Number

- 4. Lot No. _____, Recorded Plat _____
- 5. Private Claims _____

I, Randy Kolehouse, in a field survey on January 24 19 99, do hereby certify that under requirements of P.A. 74 Michigan P.A. of 1970, the corner points mentioned in lines 1 and 2 above were in conformance with regulations and rules therefore as required in the current manual of survey instructions of the United States Department of the Interior, Bureau of Land Management or by a decree of a Court of Law and/or that the corner points mentioned in lines 3, 4 and 5 above were in conformance with the rules of the Michigan Board of Land Surveyors, or by a Decree of a Court of Law; established, re-established, monumented, re-monumented, recovered, found as expressed below:

NOTE: Not more than 4 corners, all in the same town and range, may be recorded on this certificate.

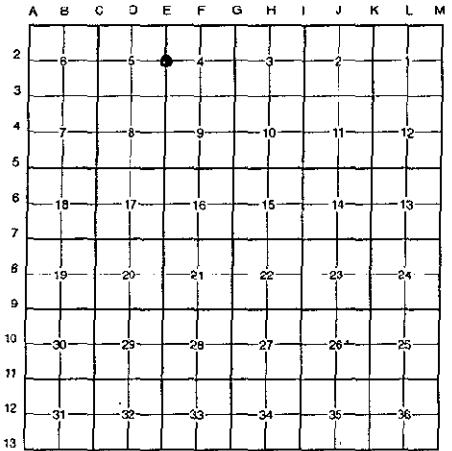

A. Description of original monument and accessories and/or subsequent restoration:

E-2	1837	G.L.O. Notes	Cathcart	Set Post
	1983	L.C.R.C. #3411	Glaza & Associates	N/A
	1983	L.C.R.C. #3633	John Bueche	Fnd. 3/4" x 18" Iron in Mon. Box / Set K.C. Monument in Mon. Box
	1988	L.C.R.C. #4814	John Bueche	K.C. Monument in a Mon. Box

This corner was originally approved by the Kent County Remonumentation Peer Group and monumented by John Bueche on 11/14/99 and was recorded per L.C.R.C. #3633.

B. Description of corner evidence found and/or method applied in restoring or reestablishing corner:

E-2 Found a Standard Kent County Monument 1.0' West of the C/L of Shaner Avenue (bit.) running North and South, on line of a fence line running East, per L.C.R.C.'s #3633 and #4814 as set by John Bueche in place of a 3/4" x 18" iron he found over a 3/4" x 18" iron in a monument box which checked L.C.R.C. #3411.

L.C.R.C. #3633

L.C.R.C. #4814

K.C. Remon. tag & nail in N side 26" Hickory S 45° E 46.41'
 K.C. Remon. tag & nail in S side 24" Hickory N 40° E 57.50'
 K.C. Remon. tag & nail in N'y side 20" Hickory N 25° E 74.91'
 K.C. Remon. tag & nail in N side 6" Elm N 30° W 47.19'
 K.C. Remon. tag & nail in N side Ash S 40° W ;74.55'
 C/L blacktop road N - S is West 1'+/-
 On fence line East & West

K.C. Remon tag & nail in N sde 28" Hickory S 45 E 46.41' (m. 46.40')
 K.C. Remon tag & nail in S sde 26" Hickory N 40 E 57.50'
 K.C. Remon tag & nail in N'y sde 22" Hickory N 25 E 74.91' (m. 74.90')
 K.C. Remon tag & nail in N sde 8" Elm N 30 W 47.19' (m. 47.15')
 K.C. Remon tag & nail in N sde Ash S 40 W 74.58' (m. 74.56')
 C/L bit rd N-S is W 1M/L
 On fence line E & W

The selected location is accepted by me and is generally accepted by professional surveyors as the best available evidence of the position of the original corner.

C. Description of monument for corner and accessories established to perpetuate locating the position of the corner:

E-2 Standard Kent County Monument

P.A. 345 1990 KENT COUNTY

- Nail & K.C. remon. tag on N side 28" Hickory S 45° E 46.40'
- Nail & K.C. remon. tag on S side 26" Hickory N 40° E 57.50'
- Nail & K.C. remon. tag on N'y side 22" Hickory N 25° E 74.90'
- Nail & K.C. remon. tag on N side 8" Elm N 30° W 47.15'
- Nail & K.C. remon. tag on N side 10" Ash S 40° W 74.56'
- C/L of bit. road running N-S, East 1.0'
- On fence line running East

PEER APPROVED 2/25/99
 CHAIRMAN [Signature]



Signed by Randy J. Kolehouse
 EARTH TECH

Date 3/30/99

Surveyor's Michigan License No. 25854