

SURVEY &
REMONUMENTATION

\$7.00
\$2.00

MAY 22 2000

LAND CORNER RECORDATION CERTIFICATE
Filing Requirement of Act 74, Mich. P.A. 1970
KENT COUNTY REMONUMENTATION

SECTION

For corners in

Kent (County)	Located in:	Courtland Township	Corner Code #
1. Public Land Survey	T 9N	R 10W	E-4
	T	R	
	T	R	
	T	R	
2. Property Controlling in Section	S	T	R
	S	T	R
3. Miscellaneous Property in Sec.	S	T	R
	S	T	R

REG. OF DEEDS

[Signature]


STATE OF MICHIGAN
COUNTY OF KENT
RECEIVED FOR RECORD
1999 OCT 15 AM 8:04

11300

Register of Deeds Stamp & File Number

4. Lot No. _____, Recorded Plat _____
5. Private Claims _____

I, Randy Kolehouse, in a field survey on January 21 19 99, do hereby certify that under requirements of P.A. 74 Michigan P.A. of 1970, the corner points mentioned in lines 1 and 2 above were in conformance with regulations and rules therefore as required in the current manual of survey instructions of the United States Department of the Interior, Bureau of Land Management or by a decree of a Court of Law and/or that the corner points mentioned in lines 3, 4 and 5 above were in conformance with the rules of the Michigan Board of Land Surveyors or by a Decree of a Court of Law; established, re-established, monumented, re-monumented, recovered, found as expressed below:

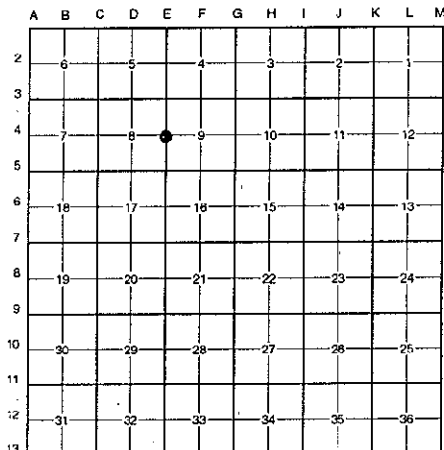

NOTE: Not more than 4 corners, all in the same town and range, may be recorded on this certificate.

A. Description of original monument and accessories and/or subsequent restoration:

E-4	1837	G.L.O. Notes	Cathcart	Set Post
	1963	Witness Map	K.C. Surveyor	1/2" Iron Over Large Stone
	1983	L.C.R.C. #3408	Glaza & Associates	N/A
	1983	L.C.R.C. #3636	John Bueche	Fnd. 1" Iron / Set K.C. Monument Over Stone

This corner was originally approved by the Kent County Remonumentation Peer Group and monumented by John Bueche on 11/14/83 and was recorded per L.C.R.C. #3408.

B. Description of corner evidence found and/or method applied in restoring or reestablishing corner:

E-4 Found a Standard Kent County Monument 2.0' West of the C/L of Shaner Avenue (bit.) running North and South, on line of a tree row running West, per L.C.R.C. #3636 as set by John Bueche in place of a 1" x 18" iron he found over a 1/2" x 30" rered over a large stone which checked L.C.R.C. #3408 and the K.C. Surveyor's records.

L.C.R.C. #3636

- K.C. Remon. tag & nail in E. side 6" Oak N 30° E 71.06'
- K.C. Remon. tag & nail in N. side power pole S 85° W 32.46' (m. 32.44')
- K.C. Remon. tag & nail in N. side 24" Oak S 80° E 76.50'
- K.C. Remon. tag & nail in S. side 24" maple S 35° E 46.57' (m. 46.57')
- K.C. Remon. tag & nail in SW'ly side 20" Maple S 25° E 67.87' (m. 67.42')
- C/L blacktop road N - S is East 2'

P.A. 345 1990 KENT COUNTY
PEER APPROVED 2/25/99
CHAIRMAN [Signature]

The selected location is accepted by me and is generally accepted by professional surveyors as the best available evidence of the position of the original corner.

C. Description of monument for corner and accessories established to perpetuate locating the position of the corner:

E-4 Standard Kent County Monument

- Nail & K.C. remon. tag on E side 8" Oak N 30° E 71.06'
- Nail & K.C. remon. tag on N side P. pole S 85° W 32.44'
- Nail & K.C. remon. tag on N side 24" Oak S 80° E 76.50'
- Nail & K.C. remon. tag on S side 24" maple S 35° E 46.57'
- Nail & K.C. remon. tag on SW side 20" Maple S 25° E 67.42'
- C/L of bit. road running N-S, East 2.0'
- On tree row running West

Signed by [Signature]
EARTH TECH

Date 3/30/99

Surveyor's Michigan License No. 25854

