

SURVEY & REMONUMENTATION

MAY 22 2000

LAND CORNER RECORDATION CERTIFICATE
Filing Requirement of Act 74, Mich. P.A. 1970
KENT COUNTY REMONUMENTATION

For corners in

Kent
 (County)

SECTION

Located in: Courtland Township

Corner Code #

- | | | | |
|------------------------------------|-------------|--------------|------------|
| 1. Public Land Survey | T <u>9N</u> | R <u>10W</u> | <u>E-6</u> |
| | T _____ | R _____ | _____ |
| | T _____ | R _____ | _____ |
| | T _____ | R _____ | _____ |
| 2. Property Controlling in Section | S _____ | T _____ | R _____ |
| | S _____ | T _____ | R _____ |
| 3. Miscellaneous Property in Sec. | S _____ | T _____ | R _____ |
| | S _____ | T _____ | R _____ |

4. Lot No. _____, Recorded Plat _____
5. Private Claims _____

REG. OF DEEDS

[Signature]

STATE OF MICHIGAN
 COUNTY OF KENT
 RECEIVED FOR RECORD
 1999 OCT 15 AM 8:04

11301

Register of Deeds Stamp & File Number

I, Randy Kolehouse, in a field survey on January 21 19 99, do hereby certify that under requirements of P.A. 74 Michigan P.A. of 1970, the corner points mentioned in lines 1 and 2 above were in conformance with regulations and rules therefore as required in the current manual of survey instructions of the United States Department of the interior, Bureau of Land Management or by a decree of a Court of Law and/or that the corner points mentioned in lines 3, 4 and 5 above were in conformance with the rules of the Michigan Board of Land Surveyors or by a Decree of a Court of Law; established, re-established, monumented, re-monumented, recovered, found as expressed below:

NOTE: Not more than 4 corners, all in the same town and range, may be recorded on this certificate.

A. Description of original monument and accessories and/or subsequent restoration:

E-6	1837	G.L.O. Notes	Cathcart	Set Post
	1963	Witness Map	K.C. Surveyor	Concrete Monument
	1983	L.C.R.C. #3422	William Byl	3/4" Iron Pipe Over Conc. Monument
	1983	L.C.R.C. #3638	John Bueche	Fnd. Concrete Monument / Set K.C. Monument
	1988	L.C.R.C. #4817	John Bueche	K.C. Monument

This corner was originally approved by the Kent County Remonumentation Peer Group and monumented by John Bueche on 11/16/83 and was recorded per L.C.R.C. #3638.

B. Description of corner evidence found and/or method applied in restoring or reestablishing corner:

E-6 Found a Standard Kent County Monument 3.0' West of the C/L of Shaner Avenue (gravel) running North and South, on line of a fence line running East, per L.C.R.C. #3638 and 4817 as set by John Bueche in place of a concrete monument he found 6" below grade which checked with L.C.R.C. #3422 and the K.C. Surveyor's records.

L.C.R.C. #3638

L.C.R.C. #4817

K.C. Remon. tag & nail in N side of 12" Oak N 60° E 58.32'
 K.C. Remon. tag & nail in S side of dbl. 15" Oak N 85° E 72.47'
 K.C. Remon. tag & nail in E side 18" Ash N 20° W 107.54'
 C/L gravel road N - S is East 3'+/-
 On fence line East

K.C. Remon tag & nail in N sde of 14" Oak N 60 E 58.32' (m. 58.51')
 K.C. Remon tag & nail in S sde of dbl. 17" Oak N 85 E 72.47' (m. 72.41')
 K.C. Remon tag & nail in E sde of 20" Ash N 20 W 107.54'
 C/L gravel rd N-S is E 3' M/L
 On fence line East

The selected location is accepted by me and is generally accepted by professional surveyors as the best available evidence of the position of the original corner.

C. Description of monument for corner and accessories established to perpetuate locating the position of the corner:


E-6 Standard Kent County Monument

P.A. 345 1990 KENT COUNTY

Nail & K.C. remon. tag on N side 14" Oak N 60° E 58.51'
 Nail & K.C. remon. tag on S side dbl. 18" Oak N 85° E 72.41'
 Nail & K.C. remon. tag on E side 22" Ash N 20° W 107.54'
 Nail & K.C. remon. tag on S side 4" x 6" fence cor. post S 88° W 21.57'
 Nail & K.C. remon. tag on W side 8" Oak S 25° E 85.88'
 C/L of gravel road running N-S, East 3.0'
 On fence line running E

PEER APPROVED 2/25/99

CHAIRMAN [Signature]

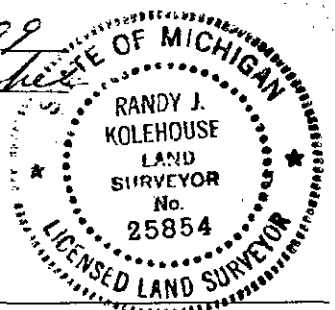

Signed by Randy Kolehouse
 EARTH TECH

Date 3/30/99

Surveyor's Michigan License No. 25854

