

MAY 22 2000

\$7.00  
\$2.00

SECTION

LAND CORNER RECORDATION CERTIFICATE  
Filing Requirement of Act 74, Mich. P.A. 1970  
KENT COUNTY REMONUMENTATION

For corners in

| Kent<br>(County)                      | Located in: Courtland<br>Township | Corner Code # |
|---------------------------------------|-----------------------------------|---------------|
| 1. Public Land Survey                 | T 9N R 10W                        | E-7           |
|                                       | T R                               |               |
|                                       | T R                               |               |
|                                       | T R                               |               |
| 2. Property Controlling<br>in Section | S T R                             |               |
|                                       | S T R                             |               |
| 3. Miscellaneous<br>Property in Sec.  | S T R                             |               |
|                                       | S T R                             |               |

REG. OF DEEDS

*[Signature]*

STATE OF MICHIGAN  
COUNTY OF KENT  
RECEIVED FOR RECORD  
1999 OCT 15 AM 8:04


11302

Register of Deeds Stamp & File Number

- 4. Lot No. \_\_\_\_\_, Recorded Plat \_\_\_\_\_
- 5. Private Claims \_\_\_\_\_

I, Randy Kolehouse, in a field survey on January 8 19 99, do hereby certify that under requirements of P.A. 74 Michigan P.A. of 1970, the corner points mentioned in lines 1 and 2 above were in conformance with regulations and rules therefore as required in the current manual of survey instructions of the United States Department of the Interior, Bureau of Land Management or by a decree of a Court of Law and/or that the corner points mentioned in lines 3, 4 and 5 above were in conformance with the rules of the Michigan Board of Land Surveyors or by a Decree of a Court of Law; established, re-established, monumented, re-monumented, recovered, found as expressed below:

NOTE: Not more than 4 corners, all in the same town and range, may be recorded on this certificate.

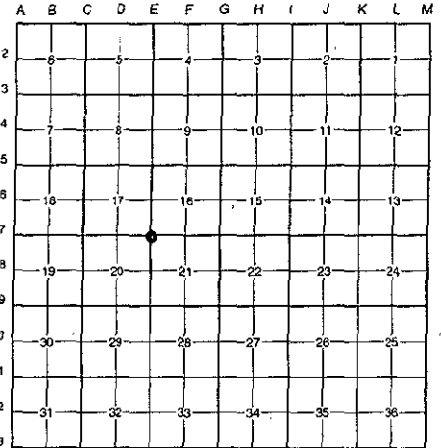

A. Description of original monument and accessories and/or subsequent restoration:

|     |      |                |                    |   |
|-----|------|----------------|--------------------|---|
| E-7 | 1837 | G.L.O. Notes   | Cathcart           | Set Post  |
|     | 1934 | Witness Map    | K.C. Surveyor      | 1" Iron   |
|     | 1980 | L.C.R.C. #2074 | Nederveld & Jonker | "T" Iron in Monument Box                              |
|     | 1982 | L.C.R.C. #2879 | Jonker Land Survey | Fnd. "T" Iron in Mon. Box / Set K.C. Mon. in Mon. Box |
|     | 1988 | L.C.R.C. #4818 | John Bueche        | K.C. Monument in Mon. Box                             |

This corner was originally approved by the Kent County Remonumentation Peer Group and monumented by Rob Jonker on 5/24/82 and was recorded per L.C.R.C. #2879.

B. Description of corner evidence found and/or method applied in restoring or reestablishing corner:

E-7 Found a Standard Kent County Monument 1.0' South of the C/L intersection of 13 Mile Road (bit.) running East and West and Shaner Avenue (bit.) running South per L.C.R.C.'s #2879 and #4818 as set by Rob Jonker in place of a "T" iron he found in a monument box which checked L.C.R.C. #2074 and the K.C. Surveyor's records.

L.C.R.C. #2879

L.C.R.C. #4818

Remon. tag on S side 9" Oak N60°W 68.98'  
Remon. tag on SE side 18" Oak N40°E 40.22'  
Sq. spike on SE side 18" Oak N30°E 37.06'  
Sq. spike on NE side 14" Oak N40°W 45.03'  
Face MBT ped. (at base) S40°E 61.05'  
Face MBT ped. (at base) S40°W 67.06'

Remon tag & nail on S sde 11" Oak N 60 W 68.97' (m. 68.92')  
Remon tag & nail on SE sde 20" Oak N 40 E 40.28' (m. 40.24')  
Sq. spike on SE sde 20" Oak N 30 E 37.06' (m. 37.04')  
Sq. spike on NE sde 16" Oak N 40 W 45.03' (m. 45.04')  
Face MBT ped. (at base) S 40 E 60.23'  
Face MBT ped. (at base) S 40 W 67.06'  
C/L E-W pavt. Is 1' N  
On C/L pavt. To S

The selected location is accepted by me and is generally accepted by professional surveyors as the best available evidence of the position of the original corner.

C. Description of monument for corner and accessories established to perpetuate locating the position of the corner:


E-7 Standard Kent County Monument

Nail & K.C. remon. tag on S side 12" Oak N 60° W 68.92'  
Nail & K.C. remon. tag on SE side 20" Oak N 40° E 40.24'  
Sq. spike nail SE side 20" Oak N 30° E 37.04'  
Nail & K.C. remon. tag on NE side 16" Oak N 40° W 45.04'  
Face M.B.T. ped. (at base) S 40° E 60.23'  
Face M.B.T. ped. (at base) S 40° W 67.06'  
C/L "X" of bit. roads running E-W-S, North 1.0'

P.A. 345 1999 KENT COUNTY

PEER APPROVED 2/25/99

CHAIRMAN [Signature]

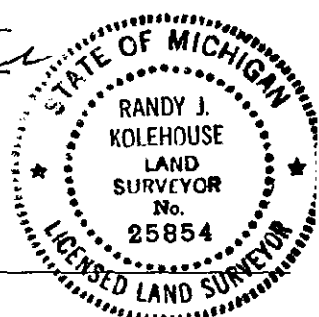

Signed by Randy J. Kolehouse

Date 3/30/99

EARTH TECH

Surveyor's Michigan License No. 25854