

MAY 22 2000

\$7.00
\$2.00

SECTION

LAND CORNER RECORDATION CERTIFICATE
Filing Requirement of Act 74, Mich. P.A. 1970
KENT COUNTY REMONUMENTATION

For corners in

Kent (County)	Located in: Courtland Township	Corner Code #
1. Public Land Survey	T <u>9N</u> R <u>10W</u>	<u>E-8</u>
	T _____ R _____	_____
	T _____ R _____	_____
	T _____ R _____	_____
2. Property Controlling in Section	S _____ T _____ R _____	_____
	S _____ T _____ R _____	_____
3. Miscellaneous Property in Sec.	S _____ T _____ R _____	_____
	S _____ T _____ R _____	_____

STATE OF MICHIGAN
COUNTY OF KENT
RECEIVED FOR RECORD

1999 OCT 15 AM 8:04


REG. OF DEEDS

11303

Register of Deeds Stamp & File Number

4. Lot No. _____, Recorded Plat _____
5. Private Claims _____

I, Randy Kolehouse, in a field survey on January 8 19 99, do hereby certify that under requirements of P.A. 74 Michigan P.A. of 1970, the corner points mentioned in lines 1 and 2 above were in conformance with regulations and rules therefore as required in the current manual of survey instructions of the United States Department of the Interior, Bureau of Land Management or by a decree of a Court of Law and/or that the corner points mentioned in lines 3, 4 and 5 above were in conformance with the rules of the Michigan Board of Land Surveyors or by a Decree of a Court of Law; established, re-established, monumented, re-monumented, recovered, found as expressed below:

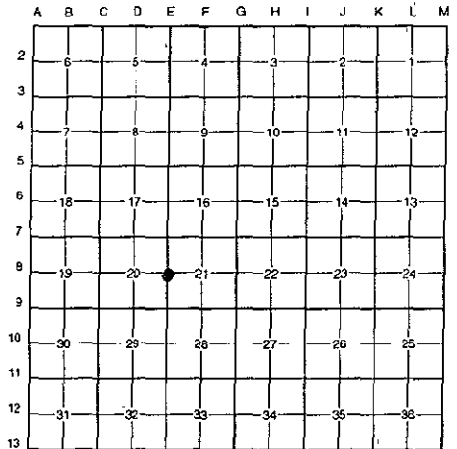

NOTE: Not more than 4 corners, all in the same town and range, may be recorded on this certificate.

A. Description of original monument and accessories and/or subsequent restoration:

E-8	1837	G.L.O. Notes	Cathcart	Set Post
	1934	Witness Map	K.C. Surveyor	Monument
	1983	L.C.R.C. #3415	Glaza & Associates	Set Iron & Cap
	1983	L.C.R.C. #3639	John Bueche	Fnd. 1/2" Rerod Over Conc. Mon. / Set K.C. Monument
	1988	L.C.R.C. #4819	Olson, Meyer & May	K.C. Monument

This corner was originally approved by the Kent County Remonumentation Peer Group and monumented by John Bueche on 11/16/83 and was recorded per L.C.R.C. #3639.

B. Description of corner evidence found and/or method applied in restoring or reestablishing corner:

E-8 Found a Standard Kent County Monument on the C/L of Shaner Avenue (bit.) running North and South, on line of a fence line and tree row running East and West, per L.C.R.C.'s #3639 and #4819 as set by John Bueche in place of a 1/2" rerod he found over a concrete monument which checked L.C.R.C. #3415 and the K.C. Surveyor's records.

L.C.R.C. #3639

L.C.R.C. #4819

NE cor. garg. fnd. S 50° W 87.75'
K.C. Remon. tag & nail in N'ly side 10" Maple N 40° W 37.26'
PK nail in N side Power Pole N 80° W 53.82'
On C/L blacktop road N-S
On fence & tree row E & W

NE cor garage fndn S 50 W 87.75' (m. 87.71')
K.C. Remon tag & nail in N'ly sde 12" Maple N 40 W 37.29' (m. 37.27')
PK nail in N sde P Pole N 80 W 53.82' (m. 53.81')
On C/L bit rd N-S
On fence & tree row E & W

The selected location is accepted by me and is generally accepted by professional surveyors as the best available evidence of the position of the original corner.

C. Description of monument for corner and accessories established to perpetuate locating the position of the corner:


E-8 Standard Kent County Monument

NE cor. gar. Fndn. S 50° W 87.71'
Nail & K.C. remon. tag on E'ly side 36" Maple N 35° W 71.41'
Nail & K.C. remon. tag on N'ly side 12" Maple N 40° W 37.27'
Nail & K.C. remon. tag on E side 24" Cherry S 15° E 84.38'
PK nail on N side P. pole N 80° W 53.81'
G/L of bit. road running N-S
On fence-line and tree row running E-W

P.A. 345 1990 KENT COUNTY

PEER APPROVED 2/25/99

CHAIRMAN *Randy Kolehouse*

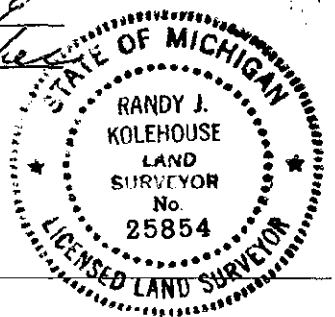

Signed by *Randy J. Kolehouse*

Date 3/30/99

EARTH TECH

Surveyor's Michigan License No. 25854