

MAY 22 2000

\$7.00  
\$2.00

SECTION

LAND CORNER RECORDATION CERTIFICATE  
Filing Requirement of Act 74, Mich. P.A. 1970  
KENT COUNTY REMONUMENTATION

For corners in

Kent (County)	Located in: Courtland Township	Corner Code #
1. Public Land Survey	T <u>9N</u> R <u>10W</u>	<u>E-9</u>
	T _____ R _____	_____
	T _____ R _____	_____
	T _____ R _____	_____
2. Property Controlling in Section	S _____ T _____ R _____	_____
	S _____ T _____ R _____	_____
3. Miscellaneous Property in Sec.	S _____ T _____ R _____	_____
	S _____ T _____ R _____	_____

REG. OF DEEDS

*[Signature]*

STATE OF MICHIGAN  
COUNTY OF KENT  
RECEIVED FOR RECORD  
1999 OCT 15 AM 8:04


11304

Register of Deeds Stamp & File Number

- 4. Lot No. \_\_\_\_\_, Recorded Plat \_\_\_\_\_
- 5. Private Claims \_\_\_\_\_

I, Randy Kolehouse, in a field survey on January 8 19 99, do hereby certify that under requirements of P.A. 74 Michigan P.A. of 1970, the corner points mentioned in lines 1 and 2 above were in conformance with regulations and rules therefore as required in the current manual of survey instructions of the United States Department of the Interior, Bureau of Land Management or by a decree of a Court of Law and/or that the corner points mentioned in lines 3, 4 and 5 above were in conformance with the rules of the Michigan Board of Land Surveyors or by a Decree of a Court of Law; established, re-established, monumented, re-monumented, recovered, found as expressed below:

NOTE: Not more than 4 corners, all in the same town and range, may be recorded on this certificate.

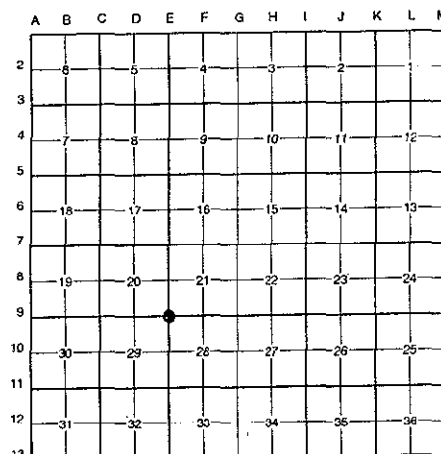

A. Description of original monument and accessories and/or subsequent restoration:

E-9	1837	G.L.O. Notes	Cathcart	Set Post
	1960	Witness Map	K.C. Surveyor	Iron in Mon. Box
	1972	L.C.R.C. #211	Exxel Engineering	Iron in Mon. Box
	1973	L.C.R.C. #584	Williams & Works	Iron in Mon. Box
	1982	L.C.R.C. #2983	Jonker Land Survey	Fnd. 1/2" Iron in Mon. Box / Set K.C. Mon. in Mon. Box
	1988	L.C.R.C. #4820	Olson, Meyer & May	K.C. Monument in Mon. Box

This corner was originally approved by the Kent County Remonumentation Peer Group and monumented by Rob Jonker on 7/8/82 and was recorded per L.C.R.C. #2983.

B. Description of corner evidence found and/or method applied in restoring or reestablishing corner:

E-9 Found a Standard Kent County Monument in a monument box at the C/L intersection of 12 Mile Road (bit.) running East and West and Shaner Avenue (bit.) running North and (gravel) running South per L.C.R.C.'s #2983 and #4820, as set by Rob Jonker in place of a 1/2" iron he found in a monument box on the North side of a 6" diameter stone and 1.0' below grade which checked L.C.R.C.'s #584, #211 and the K.C. Surveyor's records.

L.C.R.C. #2983

L.C.R.C. #4820

Remon. tag on SE side 26" Oak N60°E 63.81'  
Remon. tag on SW side 24" Hickory S35°E 69.29'  
Remon. tag on E side p.pole S30°W 165.90'  
On C/L "X" roads.

Remon tag & nail on SE sde 28" Oak N 60 E 63.81' (m. 63.85')  
Remon tag & nail on SW sde 26" Hickory S 35 E 69.29' (m. 69.31')  
Remon tag & nail on E sde P pole S 30 W 165.90'  
On C/L "X" rds  
K.C. Remon tag & nail in E sde 8" Oak S 25 W 87.46' (m. 87.42')

The selected location is accepted by me and is generally accepted by professional surveyors as the best available evidence of the position of the original corner.


C. Description of monument for corner and accessories established to perpetuate locating the position of the corner:

E-9 Standard Kent County Monument in a Monument Box

- Nail & K.C. remon. tag on SE side 28" Oak N 60° E 63.85'
- Nail & K.C. remon. tag on SW side 28" Hickory S 35° E 69.31'
- Nail & K.C. remon. tag on E side 12" Oak S 25° W 87.42'
- Nail & K.C. remon. tag on E side P. pole S 30° W 165.90'
- Nail & K.C. remon. tag on SW side P. pole N 50° W 78.39'
- C/L "X" of the roads running E-W-N and gravel road running S

P.A. 345 1990 KENT COUNTY

PEER APPROVED 2/29/99  
CHAIRMAN [Signature]

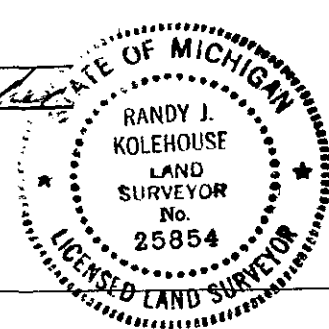

Signed by Randy J. Kolehouse  
EARTH TECH

Date 3/30/99

Surveyor's Michigan License No. 25854