

MAY 22 2000

\$7.00  
\$2.00

SECTION

LAND CORNER RECORDATION CERTIFICATE  
Filing Requirement of Act 74, Mich. P.A. 1970  
KENT COUNTY REMONUMENTATION

For corners in

Kent (County)	Located in: Courtland Township	Corner Code #
1. Public Land Survey	T <u>9N</u> R <u>10W</u>	<u>E-10</u>
	T _____ R _____	_____
	T _____ R _____	_____
	T _____ R _____	_____
2. Property Controlling in Section	S _____ T _____ R _____	_____
	S _____ T _____ R _____	_____
3. Miscellaneous Property in Sec.	S _____ T _____ R _____	_____
	S _____ T _____ R _____	_____
4. Lot No. _____, Recorded Plat _____		
5. Private Claims _____		

REG. OF DEEDS

*[Signature]*

STATE OF MICHIGAN  
COUNTY OF KENT  
RECEIVED FOR RECORD  
1999 OCT 15 AM 8:04

11305

Register of Deeds Stamp & File Number

I, Randy Kolehouse, in a field survey on January 6 19 99, do hereby certify that under requirements of P.A. 74 Michigan P.A. of 1970, the corner points mentioned in lines 1 and 2 above were in conformance with regulations and rules therefore as required in the current manual of survey instructions of the United States Department of the interior, Bureau of Land Management or by a decree of a Court of Law and/or that the corner points mentioned in lines 3, 4 and 5 above were in conformance with the rules of the Michigan Board of Land Surveyors or by a Decree of a Court of Law; established, re-established, monumented, re-monumented, recovered, found as expressed below:

NOTE: Not more than 4 corners, all in the same town and range, may be recorded on this certificate.

A. Description of original monument and accessories and/or subsequent restoration:

E-10	1837	G.L.O. Notes	Cathcart	Set Post
	1944	Witness Map	K.C. Surveyor	1-1/2" Pipe
	1975	L.C.R.C. #882	Medema, Van Kooten & Assoc.	1-1/2" Iron
	1982	L.C.R.C. #2976	Jonker Land Survey	Fnd. 1-1/2" Crimped Iron / Set K.C. Monument
	1988	L.C.R.C. #4821	John Bueche	K.C. Monument

This corner was originally approved by the Kent County Remonumentation Peer Group and monumented by Rob Jonker on 7/1/82 and was recorded per L.C.R.C. #2976.

B. Description of corner evidence found and/or method applied in restoring or reestablishing corner:

E-10 Found a Standard Kent County Monument 1.0' East of the C/L of Shaner Road (gravel) running North and South, on line of a tree row running East, per L.C.R.C.'s #2976 and #4821 as set by Rob Jonker in place of a 1-1/2" crimped iron he found which checked L.C.R.C. #882 and the K.C. Surveyor's records.

L.C.R.C. #2976

Remon. tag on NW side 48" Oak N70°E 28.11'  
Remon. tag on W side p.pole S20°E 70.86'  
On line E-W tree line  
C/L N-S gravel 1'E

L.C.R.C. #4821

Remon tag on NW sde 50" Oak N 70 E 28.11' (m. 28.07')  
Remon tag & nail in NE sde 36" Oak S 31 E 34.66' (m. 34.67')  
Remon tag & nail in W sde P pole S 20 E 70.86' (m. 70.93')  
On line E-W tree line  
C/L N-S gravel 1'E


The selected location is accepted by me and is generally accepted by professional surveyors as the best available evidence of the position of the original corner.

C. Description of monument for corner and accessories established to perpetuate locating the position of the corner:

E-10 Standard Kent County Monument  
Nail & K.C. remon. tag on NW side 50" Oak N 70° E 28.07'  
Nail & K.C. remon. tag on NE side 48" Oak S 31° E 34.67'  
Nail & K.C. remon. tag on W side P. pole S 20° E 70.93'  
Nail & K.C. remon. tag on N side twin 6" Box Elder n 85° W 43.02'  
C/L of gravel road running N-S, West 1.0'  
On tree row running East

P.A. 345 1990 KENT COUNTY

PEER APPROVED 2/25/99  
CHAIRMAN [Signature]

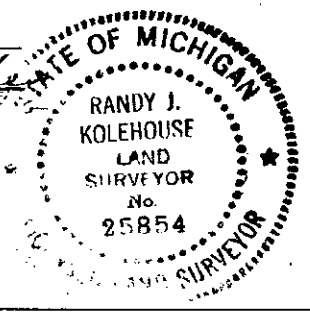

Signed by Randy J. Kolehouse  
EARTH TECH

Date 3/30/99

Surveyor's Michigan License No. 25854