

MAY 22 2000

SECTION
LAND CORNER RECORDATION CERTIFICATE
Filing Requirement of Act 74, Mich. P.A. 1970
KENT COUNTY REMONUMENTATION

For corners in

Kent (County)	Located in:	Courtland Township	Corner Code #
1. Public Land Survey	T <u>9N</u>	R <u>10W</u>	<u>E-11</u>
	T _____	R _____	_____
	T _____	R _____	_____
	T _____	R _____	_____
2. Property Controlling in Section	S _____	T _____	R _____
	S _____	T _____	R _____
3. Miscellaneous Property in Sec.	S _____	T _____	R _____
	S _____	T _____	R _____


4. Lot No. _____, Recorded Plat _____
5. Private Claims _____

1999 OCT 15 AM 8:04
STATE OF MICHIGAN
COUNTY OF KENT
RECEIVED FOR RECORD

REG. OF DEEDS

11306
Register of Deeds Stamp & File Number

I, Randy Kolehouse, in a field survey on January 5 19 99, do hereby certify that under requirements of P.A. 74 Michigan P.A. of 1970, the corner points mentioned in lines 1 and 2 above were in conformance with regulations and rules therefore as required in the current manual of survey instructions of the United States Department of the Interior, Bureau of Land Management or by a decree of a Court of Law and/or that the corner points mentioned in lines 3, 4 and 5 above were in conformance with the rules of the Michigan Board of Land Surveyors or by a Decree of a Court of Law; established, re-established, monumented, re-monumented, recovered, found as expressed below:

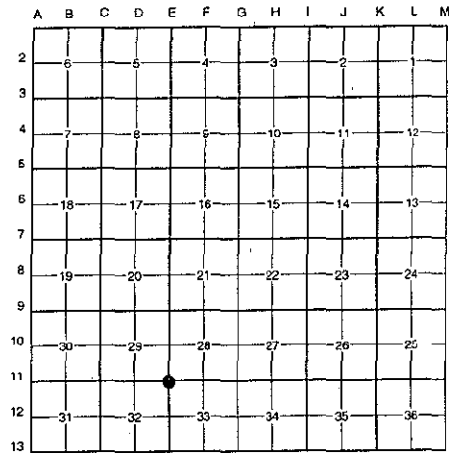

NOTE: Not more than 4 corners, all in the same town and range, may be recorded on this certificate.

A. Description of original monument and accessories and/or subsequent restoration:

E-11	1837	G.L.O. Notes	Cathcart	Set Post
	1947-49	Witness Map	K.C. Surveyor	Stone & Iron in Mon. Box
	1975	L.C.R.C. #882	Medema, Van Kooten & Assoc.	1" Iron in Mon. Box
	1982	L.C.R.C. #2975	Jonker Land Survey	Fnd. 1" Iron in Mon. Box / Set K.C. Monument in Mon. Box
	1988	L.C.R.C. #4822	John Bueche	K.C. Monument in Mon. Box

This corner was originally approved by the Kent County Remonumentation Peer Group and monumented by Rob Jonker on 7/12/82 and was recorded per L.C.R.C. #2975.

B. Description of corner evidence found and/or method applied in restoring or reestablishing corner:

E-11 Found a Standard Kent County Monument in a monument box at the C/L intersection of 11 Mile Road (bit.) running East and West and Shaner Avenue (gravel) running North and South per L.C.R.C.'s #2975 and #4822 as set by Rob Jonker in place of a 1" iron he found in a monument which checked L.C.R.C. #882 and the K.C. Surveyor's records.

L.C.R.C. #2975	L.C.R.C. #4822
SW corner house fnd. B55°E 138.5' On C/L "X" intersection.	SW cor hse fndn N 55° E 138.5' (m. 138.43') On C/L "X" inter.

The selected location is accepted by me and is generally accepted by professional surveyors as the best available evidence of the position of the original corner.

C. Description of monument for corner and accessories established to perpetuate locating the position of the corner:

E-11 Standard Kent County Monument in a Monument Box
Nail & K.C. remon. tag on NE side 12" Pine N 24° W 105.68'
Nail & K.C. remon. tag on S side P. pole S 80° W 79.44'
Nail & K.C. remon. tag on S side P. pole S 70° E 154.63'
SW cor. hse. Fndn. N 55° E 138.43'
On C/L "X" of bit. road running E-W and gravel road running N-S

P.A. 345 1990 KENT COUNTY
PEER APPROVED 2/25/99
CHAIRMAN [Signature]



Signed by Randy J. Kolehouse
EARTH TECH

Date 3/30/99

Surveyor's Michigan License No. 25854