

MAY 22 2000

\$7.00
\$2.00

SECTION

LAND CORNER RECORDATION CERTIFICATE
Filing Requirement of Act 74, Mich. P.A. 1970
KENT COUNTY REMONUMENTATION

For corners in

Kent (County)	Located in:	Courtland Township	Corner Code #
1. Public Land Survey	T <u>9N</u>	R <u>10W</u>	<u>E-12</u>
	T _____	R _____	_____
	T _____	R _____	_____
	T _____	R _____	_____
2. Property Controlling in Section	S _____	T _____	R _____
	S _____	T _____	R _____
3. Miscellaneous Property in Sec.	S _____	T _____	R _____
	S _____	T _____	R _____

4. Lot No. _____, Recorded Plat _____
 5. Private Claims _____

REG. OF DEEDS

[Signature]

STATE OF MICHIGAN
COUNTY OF KENT
RECEIVED FOR RECORD
1999 OCT 15 AM 8:04

11307

Register of Deeds Stamp & File Number

I, Randy Kolehouse, in a field survey on January 6 19 99, do hereby certify that under requirements of P.A. 74 Michigan P.A. of 1970, the corner points mentioned in lines 1 and 2 above were in conformance with regulations and rules therefore as required in the current manual of survey instructions of the United States Department of the Interior, Bureau of Land Management or by a decree of a Court of Law and/or that the corner points mentioned in lines 3, 4 and 5 above were in conformance with the rules of the Michigan Board of Land Surveyors or by a Decree of a Court of Law; established, re-established, monumented, re-monumented, recovered, found as expressed below:

NOTE: Not more than 4 corners, all in the same town and range, may be recorded on this certificate.

A. Description of original monument and accessories and/or subsequent restoration:

E-12	1837	G.L.O. Notes	Cathcart	Set Post
	1944	Witness Map	K.C. Surveyor	Pipe
	1983	L.C.R.C. #3412	Glaza & Associates	2" iron Pipe
	1983	L.C.R.C. #3642	John Bueche	Fnd. 2" Pipe / Set K.C. Monument
	1988	L.C.R.C. #4823	John Bueche	K.C. Monument

This corner was originally approved by the Kent County Remonumentation Peer Group and monumented by John Bueche on 11/15/83 and was recorded per L.C.R.C. #3642.

B. Description of corner evidence found and/or method applied in restoring or reestablishing corner:

E-12 Found a Standard Kent County Monument on the C/L of Shaner Avenue (bit.) running North and South, on line of a tree row running East and West, per L.C.R.C.'s #3642 and #4823 as set by John Bueche in place of a 2" x 30" pipe he found which checked L.C.R.C. #3412 and the K.C. Surveyor's records.

L.C.R.C. #3642

L.C.R.C. #4823

K.C. Remon. tag & nail W'ly side of 18" Maple S 20° E 83.15'
 K.C. Remon. tag & nail S side of 14" Maple S 50° W 37.81'
 K.C. Remon. tag & nail N side of 38" Maple N 85° W 25.20'
 On C/L gravel road N-S
 On fence & tree row, West

K.C. Remon tag & nail W'ly sde of 20" Maple S 20 E 83.15' (m. 83.11')
 K.C. Remon tag & nail S sde of 16" Maple S 50 W 37.81' (m. 37.80')
 K.C. Remon tag & nail N sde of 40" Maple N 85 W 25.20' (m. 25.23')
 On C/L gravel rd N-S
 On fence & tree row W


The selected location is accepted by me and is generally accepted by professional surveyors as the best available evidence of the position of the original corner.

C. Description of monument for corner and accessories established to perpetuate locating the position of the corner:

E-12 Standard Kent County Monument

Nail & K.C. remon. tag on W'ly side 20" Maple S 20° E 83.11'
 Nail & K.C. remon. tag on S'ly side 15" Maple S 50° W 37.80'
 Nail & K.C. remon. tag on N side 40" Maple N 85° W 25.23'
 Nail & K.C. remon. tag on S side 12" Maple N 85° E 48.38'
 On C/L of bit. road running N-S
 On tree row running E-W

P.A. 345 1990 KENT COUNTY
 PEER APPROVED 2/23/99
 CHAIRMAN [Signature]

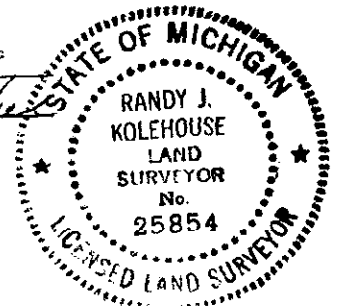

Signed by Randy J. Kolehouse

Date 3/30/99

Surveyor's Michigan License No. 25854