

SURVEY & REMONUMENTATION

\$7.00
\$2.00 MAR 03 1998

LAND CORNER RECORDATION CERTIFICATE
Filing Requirement of Act 74, Mich. P.A. 1970
KENT COUNTY REMONUMENTATION

For corners in SECTION

| Kent (County) | Located in: Courtland Township | Corner Code # |
|---------------------------------------|-----------------------------------|---------------|
| 1. Public Land Survey | T <u>9N</u> R <u>10W</u> | <u>E-13</u> |
| | T _____ R _____ | _____ |
| | T _____ R _____ | _____ |
| | T _____ R _____ | _____ |
| 2. Property Controlling in Section | S _____ T _____ R _____ | _____ |
| | S _____ T _____ R _____ | _____ |
| 3. Miscellaneous Property in Sec. | S _____ T _____ R _____ | _____ |
| | S _____ T _____ R _____ | _____ |
| 4. Lot No. _____, Recorded Plat _____ | | |
| 5. Private Claims _____ | | |

STATE OF MICHIGAN
COUNTY OF KENT
RECEIVED FOR RECORD
97 NOV 14 AM 9:01
REG. OF DEEDS
David J. Sand

10322

Register of Deeds Stamp & File Number

I, Randy Kolehouse, in a field survey on July 14 19 97, do hereby certify that under requirements of P.A. 74 Michigan P.A. of 1970, the corner points mentioned in lines 1 and 2 above were in conformance with regulations and rules therefore as required in the current manual of survey instructions of the United States Department of the interior, Bureau of Land Management or by a decree of a Court of Law and/or that the corner points mentioned in lines 3, 4 and 5 above were in conformance with the rules of the Michigan Board of Land Surveyors or by a Decree of a Court of Law; established, re-established, monumented, re-monumented, recovered, found as expressed below:

NOTE: Not more than 4 corners, all in the same town and range, may be recorded on this certificate.

A. Description of original monument and accessories and/or subsequent restoration:

| E-13 | 1831 | G.L.O. Notes | Mullett | Set Post |
|------|-----------|----------------|------------------|---------------------------------------|
| | 1903-1958 | Notes | Williams & Works | Iron/Railroad Spike |
| | 1928 | Witness Map | K.C. Surveyor | 1" Iron |
| | 1984 | L.C.R.C. #3987 | William Byl | Fnd. 1" Iron Pipe / Set K.C. Monument |
| | 1988 | L.C.R.C. #4824 | J. Bueche | K.C. Monument |

Note: This corner is not common with E-1, T8N, R10W.

This corner was originally approved by the Kent County Remonumentation Peer Group and monumented by William Byl on 10/15/84 and was recorded per L.C.R.C. #3987.

KENT COUNTY
P.A. 345 1990
PEER APPROVED 7/24/97
CHAIRMAN William Byl

B. Description of corner evidence found and/or method applied in restoring or reestablishing corner:

E-13 Found a Standard Kent County Monument 14' South of the C/L intersection of 10 Mile Road (bit.) running East and West and Shaner Avenue (bit.) running North per L.C.R.C.'s #3987 and #4824 as set by William Byl in place of a 1" iron pipe he found 30" below ground which checked the 1903-1958 notes of William & Works and the K.C. Surveyor's records.

L.C.R.C. #3987

L.C.R.C. #4824

Nail & tag, W sd. 12" Walnut S 15 E 57.69'

Nail & tag W sde 14" Walnut S 15 E 57.69'

Nail & tag, E sd. 12" Pine S 45 W 123.37'

Nail & tag E sde 14" Pine S 45 W 123.37'

"X" cut on top W end 15" culvert N 35 W 72.46'

"X" cut on top W end 15" culvt. N 26 W 72.46'

"X" cut on top E end 15" culvert N 30 E 62.49'

"X" cut on top E end 15" culvt. N 30 E 62.49'

SE cor. brick veneer of house N 35 W 191.55'

SE cor brick veneer of hse #8415 N 27 W 191.55'

S edge of asphalt pavement N 00 E 2.55'

S edge of asphalt pavt. N 0 E 2.55'

The selected location is accepted by me and is generally accepted by professional surveyors as the best available evidence of the position of the original corner.

C. Description of monument for corner and accessories established to perpetuate locating the position of the corner:

E-13 Standard Kent County Monument


Nail & K.C. remon. tag on W side 14" Walnut S 15° E 57.69'

"X" cut on top W end 15" culvert N 26° W 72.46'

"X" cut on top E end 15" culvert N 30° E 62.49'

SE cor. brick veneer of hse. #8415 N 27° W 191.55'

K.C. Mon., E-1, T8N, R10W, East 137.28'

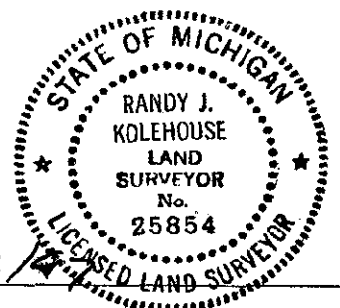

Signed by Randy J. Kolehouse

Date 9/23/97

Surveyor's Michigan License No. 25854