

MAY 22 2000

LAND CORNER RECORDATION CERTIFICATE
Filing Requirement of Act 74, Mich. P.A. 1970
KENT COUNTY REMONUMENTATION

SECTION

For corners in

Table with columns: Kent (County), Located in: Courtland Township, Corner Code #. Rows include Public Land Survey, Property Controlling in Section, and Miscellaneous Property in Sec.

STATE OF MICHIGAN
COUNTY OF KENT
RECEIVED FOR RECORD
1999 OCT 15 AM 8:04
REG. OF DEEDS

11308

Register of Deeds Stamp & File Number

4. Lot No. Recorded Plat
5. Private Claims

I, Randy Kolehouse, in a field survey on January 21 19 99, do hereby certify that under requirements of P.A. 74 Michigan P.A. of 1970, the corner points mentioned in lines 1 and 2 above were in conformance with regulations and rules therefore as required in the current manual of survey instructions of the United States Department of the interior, Bureau of Land Management or by a decree of a Court of Law and/or that the corner points mentioned in lines 3, 4 and 5 above were in conformance with the rules of the Michigan Board of Land Surveyors or by a Decree of a Court of Law; established, re-established, monumented, re-monumented, recovered, found as expressed below:

NOTE: Not more than 4 corners, all in the same town and range, may be recorded on this certificate.

A. Description of original monument and accessories and/or subsequent restoration:

Table with columns: Date, Description, Surveyor, Monument Type. Includes entries for 1963, 1979, 1986, and 1993.

Note: This corner is not common with F-13, T10N, R10W.

This corner was originally approved by the Kent County Remonumentation Peer Group and monumented by Randy Kolehouse in May of 1986 and was recorded per L.C.R.C. #4436.

B. Description of corner evidence found and/or method applied in restoring or reestablishing corner:

F-1 Found a broken Standard Kent County Monument on the C/L of 16 Mile Road (gravel) running East and West, 6.0' +/- East of the C/L of Stout Avenue (bit.) running South, and 30.0' +/- East of Stout (gravel) running North per L.C.R.C.'s #4436 and #6661 as set by Randy Kolehouse in place of a 1" iron he found on the Township line which checked L.C.R.C. #1278 and the K.C. Surveyor's records.

L.C.R.C. #4436

Nail & K.C. Remon. tag in W. side P.Pole N 30° E 70.88'
Nail & K.C. Remon. tag in E. side 18" Hick. N 40° W 94.28'
K.C. Monument at S 1/4 cor. sec. 33 T10N R10W West 35.41'

L.C.R.C. #6661

Nail & K.C. Remon. Tag in W side PP N 30° E 70.92' (m. 70.88')
Nail & K.C. Remon. Tag in E side 20" Hickory N 40° W 94.12'
NE cor. hse. Fnd. S 55° E 188.09' (m. 188.12')
NW cor. hse. Fnd. S 30° E 139.15' (m. 139.18')
K.C. Mon. (S 1/4 33, 10-10) West 35.55' (m. 35.53')


The selected location is accepted by me and is generally accepted by professional surveyors as the best available evidence of the position of the original corner.

C. Description of monument for corner and accessories established to perpetuate locating the position of the corner:

F-1 Replaced a Standard Kent County Monument

Nail & K.C. remon. tag on W side P. pole N 30° E 70.88'
Nail & K.C. remon. tag on E side 24" Hickory N 40° W 94.12'
NE cor. hse. Fndn. S 55° E 188.12'
NW cor. hse. Fndn. S 30° E 139.18'
K.C. Mon., F-13, T10N, R10W, West 35.53'

On C/L gravel road running E-W
C/L of bit. road running S, West 6.0' +/-
C/L of gravel road running N, West 30.0'

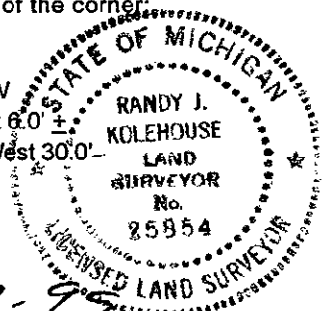

Signed by Randy J. Kolehouse
WILLIAMS & WORKS

Date 9-27-99

Surveyor's Michigan License No. 25854

