

MAY 22 2000

SECTION

LAND CORNER RECORDATION CERTIFICATE
Filing Requirement of Act 74, Mich. P.A. 1970
KENT COUNTY REMONUMENTATION


STATE OF MICHIGAN
COUNTY OF KENT
RECEIVED FOR RECORD
1999 OCT 15 AM 8:04

REG. OF DEEDS
[Signature]

11309

Register of Deeds Stamp & File Number

Form with fields: Kent (County), Located in: Courtland Township, Corner Code #, Public Land Survey, Property Controlling in Section, Miscellaneous Property in Sec., Lot No., Recorded Plat, Private Claims.

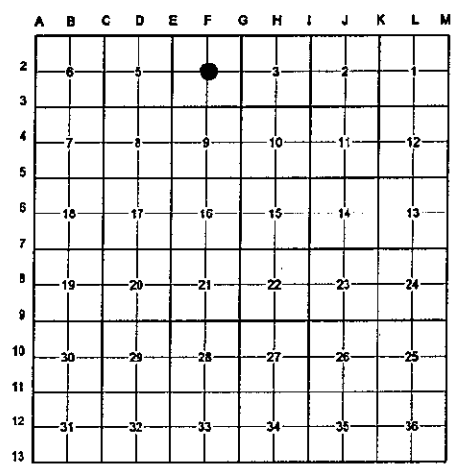

I, Randy Kolehouse, in a field survey on August 5, 1999, do hereby certify that under requirements of P.A. 74 Michigan P.A. of 1970, the corner points mentioned in lines 1 and 2 above were in conformance with regulations and rules therefore as required in the current manual of survey instructions of the United States Department of the interior, Bureau of Land Management or by a decree of a Court of Law and/or that the corner points mentioned in lines 3, 4 and 5 above were in conformance with the rules of the Michigan Board of Land Surveyors or by a Decree of a Court of Law; established, re-established, monumented, re-monumented, recovered, found as expressed below:

NOTE: Not more than 4 corners, all in the same town and range, may be recorded on this certificate.

- A. Description of original monument and accessories and/or subsequent restoration:
-2 This corner was not originally set by the G.L.O.
N/A Witness Map K.C. Surveyor Iron
N/A L.C.R.C. #5098 N/A Rebar Set @ Int. of 1/4 Lines
1994 L.C.R.C. #6978 Glaza & Associates Set K.C. Monument @ Int. of 1/4 Lines

P.A. 345 1990 KENT COUNTY
PEER APPROVED 2/25/99
CHAIRMAN [Signature]

This corner was originally approved by the Kent County Remonumentation Peer Group and monumented Glaza & Associates on 8/1/94 and was recorded per L.C.R.C. #6978.


- B. Description of corner evidence found and/or method applied in restoring or reestablishing corner:
-2 Found a PK nail on the C/L of Stout Ave. running North and South on line of tree row running East. Found a broken Standard Kent County Monument per L.C.R.C. #6978 2.5' below grade (all witnesses had been destroyed) as set by Glaza & Associates in place of a rebar they found to be at the intersection of 1/4 lines. The found Kent County Monument is 0.2' North of the intersection of 1/4 lines. Accepted monument as Center of Section.

The selected location is accepted by me and is generally accepted by professional surveyors as the best available evidence of the position of the original corner.

- C. Description of monument for corner and accessories established to perpetuate locating the position of the corner:

-2 Replaced Broken Monument with a Standard Kent County Monument

- Nail & K.C. remon. tag on N side 8" Box Elder N 80° W 28.43'
Nail & K.C. remon. tag on E side 12" Elm S 13° W 133.54'
Nail & K.C. remon. tag on W side P. pole N 23° E 212.88'
Nail & K.C. remon. tag on NW side 10" Pine N 53° E 111.17'
Mag nail on S side 12" Elm S 63° W 51.96'
Mag nail on E side 15" Oak S 28° W 90.86'

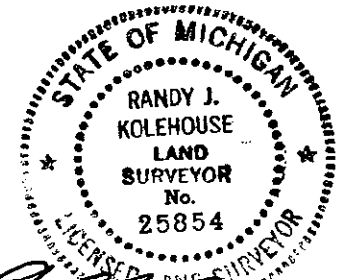

Signed by [Signature] Date 9-27-99
WILLIAMS & WORKS
Surveyor's Michigan License No. 25854