

MAY 22 2000

SECTION

**LAND CORNER RECORDATION CERTIFICATE
Filing Requirement of Act 74, Mich. P.A. 1970
KENT COUNTY REMONUMENTATION**


For corners in

<u>Kent</u> (County)	Located in: Courtland Township	Corner Code #
1. Public Land Survey	T <u>9N</u> R <u>10W</u>	<u>F-3</u>
	T _____ R _____	_____
	T _____ R _____	_____
	T _____ R _____	_____
2. Property Controlling in Section	S _____ T _____ R _____	_____
	S _____ T _____ R _____	_____
3. Miscellaneous Property in Sec.	S _____ T _____ R _____	_____
	S _____ T _____ R _____	_____

4. Lot No. _____, Recorded Plat _____
5. Private Claims _____

11310
 Register of Deeds Stamp & File Number

I, Randy Kolehouse, in a field survey on January 21 19 99, do hereby certify that under requirements of P.A. 74 Michigan P.A. of 1970, the corner points mentioned in lines 1 and 2 above were in conformance with regulations and rules therefore as required in the current manual of survey instructions of the United States Department of the Interior, Bureau of Land Management or by a decree of a Court of Law and/or that the corner points mentioned in lines 3, 4 and 5 above were in conformance with the rules of the Michigan Board of Land Surveyors or by a Decree of a Court of Law; established, re-established, monumented, re-monumented, recovered, found as expressed below:

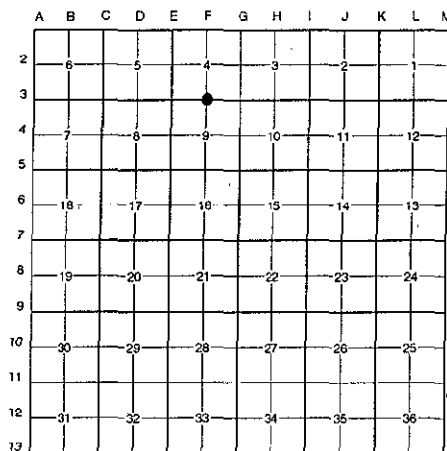

NOTE: Not more than 4 corners, all in the same town and range, may be recorded on this certificate.

A. Description of original monument and accessories and/or subsequent restoration:

F-3	1837	G.L.O. Notes	Cathcart	Set Post
	1939	Witness Map	K.C. Surveyor	3/4" Rod in Conc. Mon.
	1979	L.C.R.C. #1278	G. Hackbardt	1" Iron
	1982	L.C.R.C. #2979	Jonker Land Survey	Fnd. 1" Iron / Set K.C. Monument
	1987	L.C.R.C. #4541	T. Chettleburgh	K.C. Monument
	1988	L.C.R.C. #4825	John Bueche	K.C. Monument

This corner was originally approved by the Kent County Remonumentation Peer Group and monumented by Rob Jonker on 7/7/82 and was recorded per L.C.R.C. #2979.

B. Description of corner evidence found and/or method applied in restoring or reestablishing corner:

F-3 Found a Standard Kent County Monument at the C/L intersection of Stout Avenue (bit.) running North and South and 15 Mile Road (bit.) running East and West per L.C.R.C.'s #4541 and #4825 as set by Rob Jonker in place of a 1" iron he found at grade over a broken 4" x 24" concrete monument 12" below grade which checked L.C.R.C.'s #2979, #1278, and the K.C. Surveyor's records.

L.C.R.C. #2979	L.C.R.C. #4825
MSHD tag on SW side t.pole S35°E 38.95'	Remon tag & nail on SW sde P pole S 60 E 116.12' (m. 116.05')
Remon. tag on SW side p.pole S60°E 116.12'	Remon tag & nail in 16' tree S 20 W 120.44' (m. 120.21')
On C/L "X" of gravel roads.	Remon tag & nail in N sde 18" Maple S 60 W 105.18' (m. 105.09')
	On C/L "X" of E-W bit & N-S gravel rds.


The selected location is accepted by me and is generally accepted by professional surveyors as the best available evidence of the position of the original corner.

C. Description of monument for corner and accessories established to perpetuate locating the position of the corner:

F-3 Standard Kent County Monument

- Nail & K.C. remon. tag on SE side Telephone pole S 34° E 39.11'
- Nail & K.C. remon. tag on SW side P. pole S 55° E 116.05'
- Nail & K.C. remon. tag on E side 16" Poplar S 13° W 120.21'
- Nail & K.C. remon. tag on NW side 18" Hickory S 59° W 105.09'
- Nail & K.C. remon. tag on NE side 6" Hickory N 50° W 255.27'
- SW cor. hse. Fndn. (gar.) #12424 N 85° E 164.73'
- On C/L "X" of bit. roads running N-S-E-W

P.A. 345 1990 KENT COUNTY
PEER APPROVED 2/25/99
CHAIRMAN [Signature]

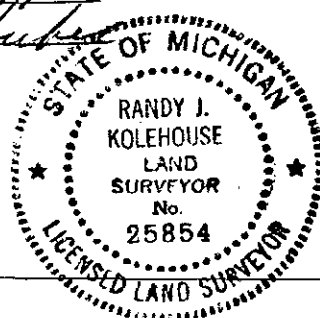

Signed by Randy J. Kolehouse
EARTH TECH

Date 3/30/99

Surveyor's Michigan License No. 25854