

MAY 22 2000

SECTION

LAND CORNER RECORDATION CERTIFICATE
Filing Requirement of Act 74, Mich. P.A. 1970
KENT COUNTY REMONUMENTATION


For corners in

Table with columns: Kent (County), Located in: Courtland Township, Corner Code #. Rows include Public Land Survey, Property Controlling in Section, and Miscellaneous Property in Sec.

REG. OF DEEDS stamp with date 1999 OCT 15 AM 8:04 and stamp number 11312. Register of Deeds Stamp & File Number.

4. Lot No. _____, Recorded Plat _____
5. Private Claims _____

I, Randy Kolehouse, in a field survey on February 1, 1999, do hereby certify that under requirements of P.A. 74 Michigan P.A. of 1970, the corner points mentioned in lines 1 and 2 above were in conformance with regulations and rules therefore as required in the current manual of survey instructions of the United States Department of the interior, Bureau of Land Management or by a decree of a Court of Law and/or that the corner points mentioned in lines 3, 4 and 5 above were in conformance with the rules of the Michigan Board of Land Surveyors or by a Decree of a Court of Law; established, re-established, monumented, re-monumented, recovered, found as expressed below:

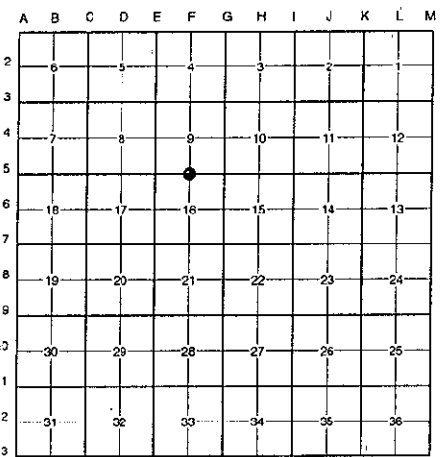

NOTE: Not more than 4 corners, all in the same town and range, may be recorded on this certificate.

A. Description of original monument and accessories and/or subsequent restoration:

Table with 4 columns: Year (1837-1988), G.L.O. Notes, Cathcart, and Set Post. Includes details like Witness Map, L.C.R.C. #3716, All-Points Surveyors, William Byl, John Bueche, Set Post, Concrete Monument, 1" Rod in Mon. Box, Fnd. Iron Pipe in Mon. Box / Set K.C. Mon. in Mon. Box, K.C. Monument in Mon. Box.

P.A. 345 1990 KENT COUNTY PEER APPROVED 2/25/99 CHAIRMAN [Signature]

This corner was originally approved by the Kent County Remonumentation Peer Group and monumented by William Byl on 9/1/83 and was recorded per L.C.R.C. #3567.

B. Description of corner evidence found and/or method applied in restoring or reestablishing corner:

F-5 Found remnants of a Standard Kent County Monument and PK nail 13.0' North of the C/L of M-57 (bit.) running East and West, 5.0' West of the C/L of Stout Avenue (gravel) running North, and the C/L of Stout Avenue (bit.) running South per L.C.R.C.'s #3567 and #4826 as set by William Byl in place of an iron pipe he found in a monument box which checked L.C.R.C. #3716 and the K.C. Surveyor's records.

L.C.R.C. #3567

L.C.R.C. #4826

Nail & tag, E sd. Transformer pole N 50 E 165.0'
Nail & tag, W sd. 12" twin Hickory N 10 W 152.5'

Nail & tag E sde Transformer pole n 50 E 165.0' (m. 164.90')
Nail & tag W sde 14" Tw. Hickory N 10 W 152.5' (m. 152.36')
C/L E-W rd (M-57) is S 13' M/L
On C/L bit rd S
C/L N gravel rd is E 5' M/L

The selected location is accepted by me and is generally accepted by professional surveyors as the best available evidence of the position of the original corner.

C. Description of monument for corner and accessories established to perpetuate locating the position of the corner:

F-5 Reset a Standard Kent County Monument

Nail & K.C. remon. tag on E side P. pole N 50° E 164.90'
Nail & K.C. remon. tag on W side 16" twin Hickory N 10° W 152.36'
Nail & K.C. remon. tag on E side N'y 0.5 x 0.5 base to sign S 46° W 185.18'
Nail & K.C. remon. tag on SW side 6" Maple S 22° E 181.32'
Meas. E to NE cor. Sec. 16 2650.37'
Meas. S to center Sec. 16 2648.63'

C/L of bit. road running E-W, South 13.0'
C/L of gravel road running N, East 5.0'
On C/L of bit. road running S

Signed by [Signature] Date 3/30/99
EARTH TECH

Surveyor's Michigan License No. 25854

