

MAY 22 2000

1/2

SECTION

LAND CORNER RECORDATION CERTIFICATE
Filing Requirement of Act 74, Mich. P.A. 1970
KENT COUNTY REMONUMENTATION

For corners in

Table with columns: Kent (County), Located in: Courtland Township, Corner Code #. Rows include Public Land Survey, Property Controlling in Section, and Miscellaneous Property in Sec.


1999 OCT 15 AM 8:04
STATE OF MICHIGAN
COUNTY OF KENT
RECEIVED FOR RECORD
REG. OF DEEDS

11313

Register of Deeds Stamp & File Number

4. Lot No. , Recorded Plat
5. Private Claims

I, Randy Kolehouse, in a field survey on January 8, 1999, do hereby certify that under requirements of P.A. 74 Michigan P.A. of 1970, the corner points mentioned in lines 1 and 2 above were in conformance with regulations and rules therefore as required in the current manual of survey instructions of the United States Department of the interior, Bureau of Land Management or by a decree of a Court of Law and/or that the corner points mentioned in lines 3, 4 and 5 above were in conformance with the rules of the Michigan Board of Land Surveyors or by a Decree of a Court of Law; established, re-established, monumented, re-monumented, recovered, found as expressed below:

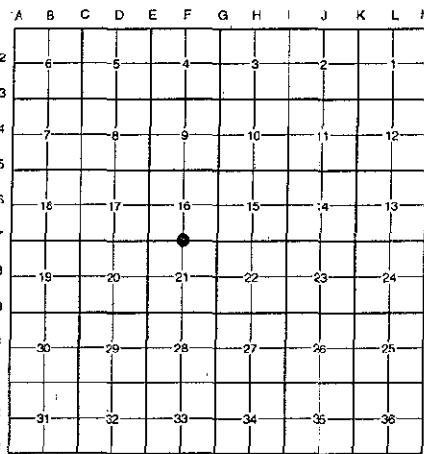

NOTE: Not more than 4 corners, all in the same town and range, may be recorded on this certificate.

A. Description of original monument and accessories and/or subsequent restoration:

Table with 4 columns: Date (1837-1988), Description (G.L.O. Notes, Witness Map, L.C.R.C. #3718, #3594, #4827), Name (Cathcart, K.C. Surveyor, All-Points Surveyors, William Byl, John Bueche), and Monument Type (Set Post, Stone at Surface, 3/4" Iron, Limestone with 3/4" Iron Pipe / Set K.C. Monument, K.C. Monument).

This corner was originally approved by the Kent County Remonumentation Peer Group and monumented by William Byl on 9/1/83 and was recorded per L.C.R.C. #3594.

B. Description of corner evidence found and/or method applied in restoring or reestablishing corner:

F-7 Found a Standard Kent County Monument in a monument box at the C/L intersection of 13 Mile Road (bit.) running East and West and Stout Avenue (gravel) running North per L.C.R.C.'s #3594 and #4827 as set by William Byl in place of a piece of 4" x 12" limestone he found with a 3/4" iron pipe on the West side which checked L.C.R.C. #3718 and the K.C. Surveyor's records.

L.C.R.C. #3594

L.C.R.C. #4827

Nail & tag, W sd. Power pole S 55° W 104.45'
Iron Pipe N 90 W 0.70'


Nail & tag E sde 38" Oak S 25 E 29.60'
Nail & tag W sde P pole S 55 W 104.45' (m. 104.36')
Iron pipe N 90 W .70'
Mon is on C/L N rd & on C/L E-W rd

The selected location is accepted by me and is generally accepted by professional surveyors as the best available evidence of the position of the original corner.

C. Description of monument for corner and accessories established to perpetuate locating the position of the corner:

- F-7 Standard Kent County Monument in a Monument Box
Nail & K.C. remon. tag on E side 40" Oak S 25° E 29.60'
Nail & K.C. remon. tag on NW side P. pole S 55° W 104.36'
Nail & K.C. remon. tag on E side P. pole N 20° E 219.69'
Nail & K.C. remon. tag on E side P. pole N 30° W 231.58'
Nail & K.C. remon. tag on S side 8" Maple S 70° E 114.97'
Nail & K.C. remon. tag on NE side triple 8" Maple S 60° E 62.80'
3/4" Iron pipe N 90° W 0.70'
On C/L "X" of bit. & gravel roads running E-W-N

P.A. 345 1990 KENT COUNTY
PEER APPROVED 2/25/99
CHAIRMAN

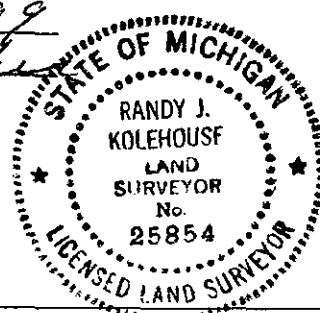

Signed by Randy J. Kolehouse
EARTH TECH

Date 3/30/99

Surveyor's Michigan License No. 25854