

MAY 22 2000

SECTION

LAND CORNER RECORDATION CERTIFICATE
Filing Requirement of Act 74, Mich. P.A. 1970
KENT COUNTY REMONUMENTATION

For corners in

Kent (County)	Located in:	Courtland Township	Corner Code #
1. Public Land Survey	T <u>9N</u>	R <u>10W</u>	<u>F-11</u>
	T _____	R _____	_____
	T _____	R _____	_____
	T _____	R _____	_____
2. Property Controlling in Section	S _____	T _____	R _____
	S _____	T _____	R _____
3. Miscellaneous Property in Sec.	S _____	T _____	R _____
	S _____	T _____	R _____

REG. OF DEEDS

STATE OF MICHIGAN
COUNTY OF KENT
RECEIVED FOR RECORD
1999 OCT 15 AM 8:04


11315

Register of Deeds Stamp & File Number

- 4. Lot No. _____, Recorded Plat _____
- 5. Private Claims _____

I, Randy Kolehouse, in a field survey on January 5 19 99, do hereby certify that under requirements of P.A. 74 Michigan P.A. of 1970, the corner points mentioned in lines 1 and 2 above were in conformance with regulations and rules therefore as required in the current manual of survey instructions of the United States Department of the interior, Bureau of Land Management or by a decree of a Court of Law and/or that the corner points mentioned in lines 3, 4 and 5 above were in conformance with the rules of the Michigan Board of Land Surveyors or by a Decree of a Court of Law; established, re-established, monumented, re-monumented, recovered, found as expressed below:

NOTE: Not more than 4 corners, all in the same town and range, may be recorded on this certificate.

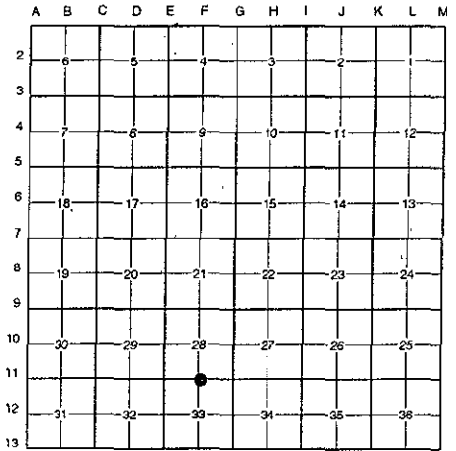

A. Description of original monument and accessories and/or subsequent restoration:

F-11	1837	G.L.O. Notes	Cathcart	Set Post
	1944	Witness Map	K.C. Surveyor	Monument Box
	1983	L.C.R.C. #3416	Glaza & Associates	Monument Box
	1983	L.C.R.C. #3641	John Bueche	Find. Mon. in Mon. Box / Set K.C. Monument in Mon. Box
	1988	L.C.R.C. #4828	John Bueche	K.C. Monument in Mon. Box

This corner was originally approved by the Kent County Remonumentation Peer Group and monumented by John Bueche on 11/16/83 and was recorded per L.C.R.C. #3641.

B. Description of corner evidence found and/or method applied in restoring or reestablishing corner:

F-11 Found a Standard Kent County Monument 4.8' South of the C/L of 11 Mile Road (bit.) running East and West, on line of a tree row and fence line running South, per L.C.R.C.'s #3641 and 4828 as set by John Bueche in place of a monument he found in a monument box which checked L.C.R.C. #3416 and the K.C. Surveyor's records.

L.C.R.C. #3641

L.C.R.C. #4828

K.C. Remon. tag & nail in E side Power pole N 30° E 64.21'
K.C. Remon. tag & nail in NW side 15" Oak S 80° W 96.77'

K.C. Remon tag & nail in E sde P pole N 30 E 64.21' (m. 64.16')
K.C. Remon tag & nail in NW sde 17" Oak S 80 W 96.83' (m. 96.82')

The selected location is accepted by me and is generally accepted by professional surveyors as the best available evidence of the position of the original corner.

C. Description of monument for corner and accessories established to perpetuate locating the position of the corner:

F-11 Standard Kent County Monument

- Nail & K.C. remon. tag on W side P. pole S 05° W 57.70'
- Nail & K.C. remon. tag on NW side 17" Oak S 80° W 96.82'
- Nail & K.C. remon. tag on E side P. pole N 30° E 64.16'
- Nail & K.C. remon. tag on S side 15" maple N 60° E 92.58'
- All points cap #17639 North 32.93'
- On C/L of bit. road running E-W
- On tree row and fence line running S

P.A. 645 1970 KENT COUNTY

PEER APPROVED 2/25/99

CHAIRMAN



Signed by Randy J. Kolehouse

Date 3/30/99

Surveyor's Michigan License No. 25854