

**SURVEY & REMONUMENTATION**

\$7.00  
\$2.00

MAR 03 1998

**LAND CORNER RECORDATION CERTIFICATE**  
Filing Requirement of Act 74, Mich. P.A. 1970  
KENT COUNTY REMONUMENTATION

STATE OF MICHIGAN  
COUNTY OF KENT  
RECEIVED FOR RECORD  
97 NOV 14 AM 9:01  
REG. OF DEEDS  
*W. J. Kulehouse*

**SECTION**


For corners in

Kent (County)	Located in: Courtland Township	Corner Code #
1. Public Land Survey	T <u>9N</u> R <u>10W</u>	<u>F-13</u>
	T _____ R _____	_____
	T _____ R _____	_____
	T _____ R _____	_____
2. Property Controlling In Section	S _____ T _____ R _____	_____
	S _____ T _____ R _____	_____
3. Miscellaneous Property in Sec.	S _____ T _____ R _____	_____
	S _____ T _____ R _____	_____

**10323**  
Register of Deeds Stamp & File Number

4. Lot No. \_\_\_\_\_, Recorded Plat \_\_\_\_\_  
5. Private Claims \_\_\_\_\_

I, Randy Kolehouse, in a field survey on July 14 19 97, do hereby certify that under requirements of P.A. 74 Michigan P.A. of 1970, the corner points mentioned in lines 1 and 2 above were in conformance with regulations and rules therefore as required in the current manual of survey instructions of the United States Department of the Interior, Bureau of Land Management or by a decree of a Court of Law and/or that the corner points mentioned in lines 3, 4 and 5 above were in conformance with the rules of the Michigan Board of Land Surveyors or by a Decree of a Court of Law; established, re-established, monumented, re-monumented, recovered, found as expressed below:

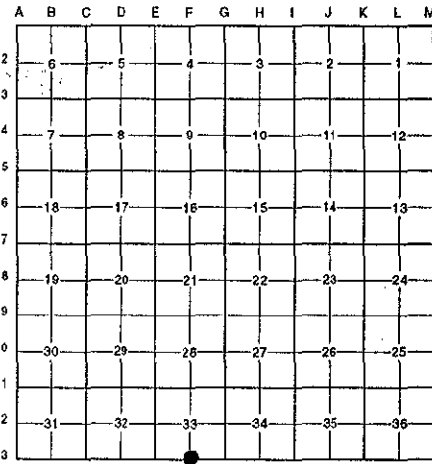

**NOTE:** Not more than 4 corners, all in the same town and range, may be recorded on this certificate.

**A. Description of original monument and accessories and/or subsequent restoration:**

F-13	1831	G.L.O. Notes	Mullett	Set Post
	1936	Witness Map	K.C. Surveyor	Stone and Iron/Mon. Box
	1980	L.C.R.C. #2088	Nederveld and Jonker Surveying	Round Iron in Mon. Box
	1982	L.C.R.C. #2885	Jonker Land Surveys	Fnd. 3/4" Rd. Iron in Mon. Box / Set K.C. Monument
	1988	L.C.R.C. #4829	J. Bueche	K.C. Monument

Note: This corner is not common with F-1, T8N, R10W.

This corner was originally approved by the Kent County Remonumentation Peer Group and monumented by Rob Jonker on 5/24/82 and was recorded per L.C.R.C. #2885.

**B. Description of corner evidence found and/or method applied in restoring or reestablishing corner:**

F-13 Found a Standard Kent County Monument in a monument box on the C/L of 10 Mile Road (bit.) running East and West and 125' ± West of the C/L of Myers Lake Avenue (bit.) running North and South per L.C.R.C.'s #2885 and #4829 as set by Rob Jonker in place of a 3/4" iron he found in a monument box which checked L.C.R.C. #2088 and the K.C. Surveyor's records.

L.C.R.C. #2885

Large spike on E side p & t poles S0°E 63.64'  
Remon. tag on S side p.pole S60°E 87.26'  
C/L mon. box at C/L "X" S90°E 124.84'  
NW corner conc. porch fnd. S40°W 93.61'

L.C.R.C. #4829

Large Spk on E sde P & T poles S 0 E 63.64'  
Top C/L on SW Bolt to Boron sign N 15 E 56.80'  
Remon tag & nail on S sde P pole S 60 E 87.26'  
C/L Mon Box at C/L "X" S 90 E 124.84'  
NW cor conc porch fndn S 40 W 93.61'


The selected location is accepted by me and is generally accepted by professional surveyors as the best available evidence of the position of the original corner.

**C. Description of monument for corner and accessories established to perpetuate locating the position of the corner:**

F-13 Standard Kent County Monument in a Monument Box

- Nail & K.C. remon. tag on E side P. pole S 00° E 63.64'
- Top C/L on SW bolt to BP sign N 15° E 56.80'
- Nail & K.C. remon. tag on S side P. pole S 60° E 87.26'
- NW cor. conc. porch fndn. S 40° W 93.61'
- K.C. Mon., F-1, T8N, R10W, East 124.84'

P.A. 345 1990 KENT COUNTY  
PEER APPROVED 7/24/97  
CHAIRMAN Harry Huber

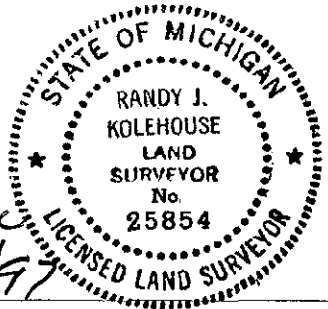

Signed by Randy J. Kolehouse  
EARTH TECH

Date 9/23/97

Surveyor's Michigan License No. 25854