SURVEY & REMONUMENTATION

MAY 22 2000

7/2

SECTION

LAND CORNER RECORDATION CERTIFICATE

Filing Requirement of Act 74, Mich. P.A. 1970

KENT COUNTY REMONUMENTATION

STATE OF MICHIGAN COUNTY OF KENT RECEIVED FOR RECORD 1999 OCT 15 AM 8:04

REG. OF DEEDS

11317

Register of Deeds Stamp & File Number

For corners in Kent (County) — Located in: Courtland Township — Corner Code #

1. Public Land Survey		T 9N	R 10W	G-2	
		T	R		
		T	R		
		T	R		
2. Property Controlling	S	T	R		
in Section	S	T	R		
3. Miscellaneous	S	T	R		
Property in Sec.	S	T	R		

4. Lot No._____, Recorded Plat _____

5. Private Claims _____

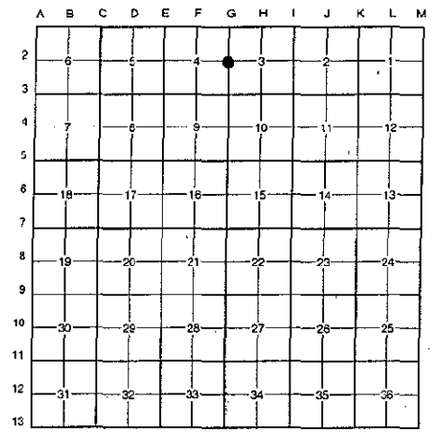

I, Randy Kolehouse, in a field survey on January 21 19 99, do hereby certify that under requirements of P.A. 74 Michigan P.A. of 1970, the corner points mentioned in lines 1 and 2 above were in conformance with regulations and rules therefore as required in the current manual of survey instructions of the United States Department of the interior, Bureau of Land Management or by a decree of a Court of Law and/or that the corner points mentioned in lines 3, 4 and 5 above were in conformance with the rules of the Michigan Board of Land Surveyors or by a Decree of a Court of Law; established, re-established, monumented, re-monumented, recovered, found as expressed below:

NOTE: ***Not more than 4 corners, all in the same town and range, may be recorded on this certificate.***

A. Description of original monument and accessories and/or subsequent restoration:

G-2	1837	G.L.O. Notes	Cathcart	Set Post
	1939-51	Witness Map	K.C. Surveyor	Monument
	1983	L.C.R.C. #3409	Glaza & Associates	N/A
	1983	L.C.R.C. #3634	John Bueche	Fnd. 3/4" Iron / Set K.C. Monument
	1988	L.C.R.C. #4830	John Bueche	K.C. Monument

P.A. 345 1990 KENT COUNTY
PEER APPROVED 2/25/99
CHAIRMAN

This corner was originally approved by the Kent County Remonumentation Peer Group and monumented by John Bueche on 11/14/83 and was recorded per L.C.R.C. #3634.

B. Description of corner evidence found and/or method applied in restoring or reestablishing corner:

G-2 *Found a Standard Kent County Monument 1.0' West of the C/L of Myers Lake Avenue (bit.) running North and South, on line of a fence line and tree row running East and West, per L.C.R.C.'s #3634 and #4830 as set by John Bueche in place of a 3/4" x 18" iron he found inside a 1" x 18" iron over a concrete monument which checked L.C.R.C. #3409 and the K.C. Surveyor's records.*

L.C.R.C. #3634

K.C. Remon. tag & nail in N side 36" Ash S 85° E 35.20'
K.C. Remon. tag & nail in S'ly side dbl. 12" Box Elder n 90° W 62.14
K.C. Remon. tag & nail in E side 28" maple N 20° W 77.16'
PK in E side of 28" Maple N 40° W 84.67'
PK in S'ly of power pole S 35° E 55.23'
C/L blacktop road N - S is East 1'+/-
On fence line East
On fence & tree row West

L.C.R.C. #4830

K.C. Remon tag & nail in N sde 38" Ash S 85 E 35.20' (m. 35.17')
K.C. Remon tag & nail in S'ly sde dbl. 14" Box Elder N 90 W 62.09' (m. 62.17')
K.C. Remon tag & nail in E sde 30" Maple N 20 W 77.16' (m. 77.18')
Nail & tag in E sde of 30" Maple N 40 W 84.94' (m. 84.92')
PK in S'ly sde of P pole S 35 E 55.23' (m. 55.25')
C/L bit rd N-S is E 1' M/L
On fence line E
On fence & tree row W

The selected location is accepted by me and is generally accepted by professional surveyors as the best available evidence of the position of the original corner.

C. Description of *monument for corner and accessories established to perpetuate locating the position of the corner:*

G-2 Standard Kent County Monument

Nail & K.C. remon. tag on N side 40" Ash S 85° E 35.17'
Nail & K.C. remon. tag on S'ly side 15" double Box Elder N 90° W 62.17'
Nail & K.C. remon. tag on E side 34" Maple N 80° W 84.92'
Nail & K.C. remon. tag on E side 32" Maple N 20° W 77.18'
Nail & K.C. remon. tag on SW side P. pole S 35° E 55.25'
C/L of bit. road running N-S, East 1.0'
On C/L of fence line and tree row running E-W

Signed by Randy J Kolehouse Date 3/30/99
EARTH TECH

Surveyor's Michigan License No. 25854

STATE OF MICHIGAN RANDY J. KOLEHOUSE LAND SURVEYOR No. 25854 LICENSED LAND SURVEYOR

FORM APPROVED BY MICHIGAN STATE BOARD OF LAND SURVEYORS, JAN. 28, 1971 REVISED MAY 14, 1975 REVISED JAN. 1983