

MAY 22 2000

SECTION


LAND CORNER RECORDATION CERTIFICATE
Filing Requirement of Act 74, Mich. P.A. 1970
KENT COUNTY REMONUMENTATION

For corners in

Kent (County)	Located in: Courtland Township	Corner Code #
1. Public Land Survey	T <u>9N</u> R <u>10W</u>	<u>G-3</u>
	T _____ R _____	_____
	T _____ R _____	_____
	T _____ R _____	_____
2. Property Controlling in Section	S _____ T _____ R _____	_____
	S _____ T _____ R _____	_____
3. Miscellaneous Property in Sec.	S _____ T _____ R _____	_____
	S _____ T _____ R _____	_____
4. Lot No. _____, Recorded Plat _____		
5. Private Claims _____		

STATE OF MICHIGAN
COUNTY OF KENT
RECEIVED FOR RECORD
1999 OCT 15 AM 8:04
REG. OF DEEDS

11318
Register of Deeds Stamp & File Number

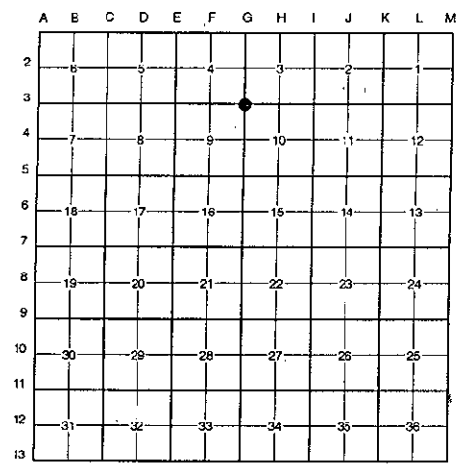

I, Randy Kolehouse, in a field survey on January 21 19 99, do hereby certify that under requirements of P.A. 74 Michigan P.A. of 1970, the corner points mentioned in lines 1 and 2 above were in conformance with regulations and rules therefore as required in the current manual of survey instructions of the United States Department of the interior, Bureau of Land Management or by a decree of a Court of Law and/or that the corner points mentioned in lines 3, 4 and 5 above were in conformance with the rules of the Michigan Board of Land Surveyors or by a Decree of a Court of Law; established, re-established, monumented, re-monumented, recovered, found as expressed below:

NOTE: Not more than 4 corners, all in the same town and range, may be recorded on this certificate.

A. Description of original monument and accessories and/or subsequent restoration:

G-3	1837	G.L.O. Notes	Cathcart	Set Post
	1939-51	Witness Map	K.C. Surveyor	Monument
	1981	L.C.R.C. #2485	Glaza & Associates	1-1/4" Iron
	1982	L.C.R.C. #2878	Jonker Land Survey	Fnd. 3/4" Iron / Set K.C. Monument
	1988	L.C.R.C. #4831	Olson, Meyer & May	K.C. Monument

This corner was originally approved by the Kent County Remonumentation Peer Group and monumented by Rob Jonker on 5/25/82 and was recorded per L.C.R.C. #2878.

B. Description of corner evidence found and/or method applied in restoring or reestablishing corner:

G-3 Found a Standard Kent County Monument at the C/L intersection of Myers Lake Avenue (bit.) running North and South and 15 Mile Road (bit.) running East and West per L.C.R.C.'s #2878 and #4831 as set by Rob Jonker in place of a 3/4" iron he found at grade over a broken 4" x 24" concrete monument 18" below grade which checked L.C.R.C. #2485 and the K.C. Surveyor's records.

L.C.R.C. #2878

L.C.R.C. #4831

Remon. tag on N side p.pole S65°W 55.79'
Chisled "X" on W end conc. culv. N12°W 75.5'
SW corner conc. porch N40°E 107.21'
NW corner hse. S55°E 117.9'

Remon tag & nail on N sde P pole S 65 W 55.79' (m. 55.87')
SW cor conc porch N 40 E 107.21' (m. 107.12')
NW cor hse S 55 E 117.9' (m. 117.61')
NW cor conc slab for M.B.T. Box S 70 E 60.08' (m. 64.35')


The selected location is accepted by me and is generally accepted by professional surveyors as the best available evidence of the position of the original corner.

C. Description of monument for corner and accessories established to perpetuate locating the position of the corner:

G-3 Standard Kent County Monument

Nail & K.C. remon. tag on N side P. pole S 65° W 55.87'
Nail & K.C. remon. tag on S side 20" Walnut N 35° E 56.71'
SW cor. conc. porch N 40° E 107.12'
NW cor. hse. S 55° E 117.61'
NW cor. conc. slab for MBT box S 70° E 64.35'
Chisled "X" W end conc. culv. N 12° W 77.58'
On C/L "X" of bit. roads running N-S & E-W

P.A. 345 1990 KENT COUNTY
PEER APPROVED 2/25/99
CHAIRMAN [Signature]

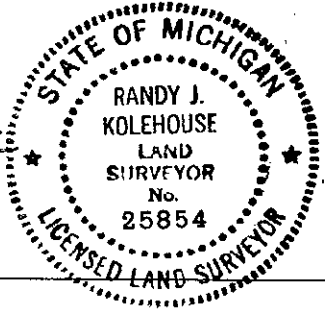

Signed by [Signature]
EARTH TECH

Date 3/30/99

Surveyor's Michigan License No. 25854