

MAY 22 2000

1/2

SECTION

LAND CORNER RECORDATION CERTIFICATE
Filing Requirement of Act 74, Mich. P.A. 1970
KENT COUNTY REMONUMENTATION

For corners in


Table with columns: Kent (County), Located in: Courtland Township, Corner Code #. Rows include Public Land Survey, Property Controlling in Section, Miscellaneous Property in Sec., Lot No., and Private Claims.

REG. OF DEEDS
1999 OCT 15 AM 8:04
STATE OF MICHIGAN
COUNTY OF KENT
RECEIVED FOR RECORD

11319

Register of Deeds Stamp & File Number

I, Randy Kolehouse, in a field survey on January 21 19 99, do hereby certify that under requirements of P.A. 74 Michigan P.A. of 1970, the corner points mentioned in lines 1 and 2 above were in conformance with regulations and rules therefore as required in the current manual of survey instructions of the United States Department of the interior, Bureau of Land Management or by a decree of a Court of Law and/or that the corner points mentioned in lines 3, 4 and 5 above were in conformance with the rules of the Michigan Board of Land Surveyors or by a Decree of a Court of Law; established, re-established, monumented, re-monumented, recovered, found as expressed below:

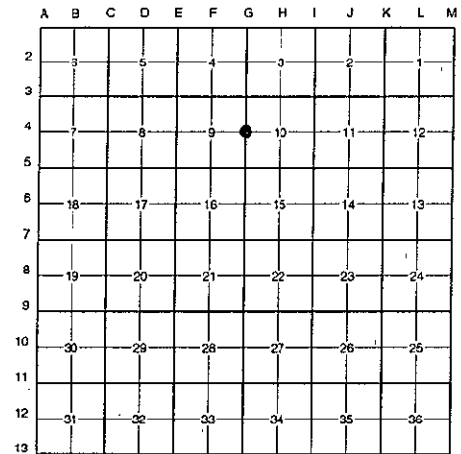

NOTE: Not more than 4 corners, all in the same town and range, may be recorded on this certificate.

A. Description of original monument and accessories and/or subsequent restoration:

Table with columns: G-4, 1837, G.L.O. Notes, Cathcart, Set Post, 1963, Witness Map, K.C. Surveyor, 3/4" Pipe, 1980, L.C.R.C. #1401, Glaza & Associates, 3/4" Iron, 1982, L.C.R.C. #3043, Jonker Land Survey, Fnd. 3/4" Iron / Set K.C. Monument, 198, L.C.R.C. #4832, Olson, Meyer & May, K.C. Monument

This corner was originally approved by the Kent County Remonumentation Peer Group and monumented by Rob Jonker on 8/4/82 and was recorded per L.C.R.C. #3043.

B. Description of corner evidence found and/or method applied in restoring or reestablishing corner:

G-4 Found a Standard Kent County Monument 1.0' West of the C/L of Myers Lake Avenue (bit.) running North and South, on line of a fence line and tree row running East and West, per L.C.R.C.'s #3043 and #4832 as set by Rob Jonker in place of a 3/4" iron he found at grade over a 4" x 36" concrete monument 12" below grade per L.C.R.C. #1401 and the K.C. Surveyor's records.

L.C.R.C. #3043

L.C.R.C. #4832

Remon. tag on N side 20" Hickory N90°E 29.96'
Remon. tag on NW side p.pole N35°E 63.41'
Remon. tag on N side 28" Maple N80°W 29.74'
On fence & tree lines W & E
C/L N-S pvt. 1'E

Remon tag & nail on N sde 22" Hickory N 90 E 29.96'
Remon tag & nail on NW sde P pole N 35 E 63.41' (m. 63.42')
Remon tag & nail on N sde 30" Maple N 80 W 29.74' (m. 30.11')
On fence & tree lines W & E
C/L N-S pvt. 1' E


The selected location is accepted by me and is generally accepted by professional surveyors as the best available evidence of the position of the original corner.

C. Description of monument for corner and accessories established to perpetuate locating the position of the corner:

G-4 Standard Kent County Monument

Nail & K.C. remon. tag on N side 22" Hickory East 29.96'
Nail & K.C. remon. tag on NW side P. pole N 35° E 63.42'
Nail & K.C. remon. tag on N side 30" maple N 80° W 30.11'
Nail & K.C. remon. tag on E side P. pole N 25° E 99.12'
C/L of bit. road running N-S, East 1.0'
On fence line and tree row running E-W

P.A. 345 1990 KENT COUNTY
PEER APPROVED 2/25/99
CHAIRMAN Randy Kolehouse

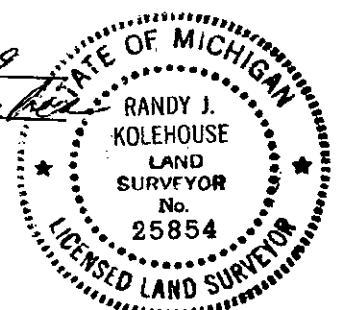

Signed by Randy Kolehouse

Date 3/30/99

Surveyor's Michigan License No. 25854