

MAY 22 2000

SECTION

LAND CORNER RECORDATION CERTIFICATE
Filing Requirement of Act 74, Mich. P.A. 1970
KENT COUNTY REMONUMENTATION

For corners in

Kent (County)	Located in: Courtland Township	Corner Code #
1. Public Land Survey	T <u>9N</u> R <u>10W</u>	<u>G-5</u>
	T _____ R _____	_____
	T _____ R _____	_____
	T _____ R _____	_____
2. Property Controlling in Section	S _____ T _____ R _____	_____
	S _____ T _____ R _____	_____
3. Miscellaneous Property in Sec.	S _____ T _____ R _____	_____
	S _____ T _____ R _____	_____

REG. OF DEEDS

[Signature]


STATE OF MICHIGAN
COUNTY OF KENT
RECEIVED FOR RECORD
1999 OCT 15 AM 8:05

11320

Register of Deeds Stamp & File Number

4. Lot No. _____, Recorded Plat _____
5. Private Claims _____

I, Randy Kolehouse, in a field survey on February 1 19 99, do hereby certify that under requirements of P.A. 74 Michigan P.A. of 1970, the corner points mentioned in lines 1 and 2 above were in conformance with regulations and rules therefore as required in the current manual of survey instructions of the United States Department of the interior, Bureau of Land Management or by a decree of a Court of Law and/or that the corner points mentioned in lines 3, 4 and 5 above were in conformance with the rules of the Michigan Board of Land Surveyors or by a Decree of a Court of Law; established, re-established, monumented, re-monumented, recovered, found as expressed below:

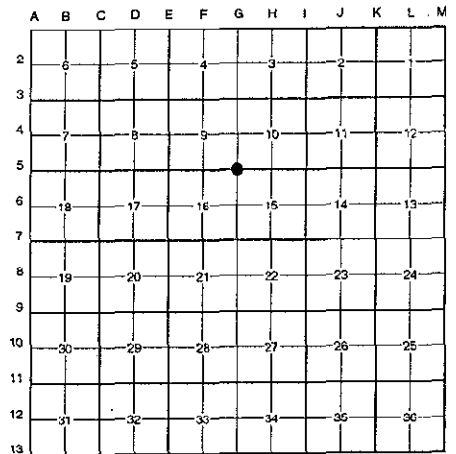

NOTE: Not more than 4 corners, all in the same town and range, may be recorded on this certificate.

A. Description of original monument and accessories and/or subsequent restoration:

G-5	1837	G.L.O. Notes	Cathcart	Set Post
	1939-63	Witness Map	K.C. Surveyor	Iron in Monument
	1980	L.C.R.C. #1394	Moore & Bruggink	Iron in Monument Box
	1982	L.C.R.C. #3044	Jonker Land Survey	Fnd. 3/4" Iron in Mon. Box
	1988	L.C.R.C. #4833	Olson, Meyer & May	K.C. Monument in Mon. Box

This corner was originally approved by the Kent County Remonumentation Peer Group and monumented by Rob Jonker on 8/2/82 and was recorded per L.C.R.C. #3044.

B. Description of corner evidence found and/or method applied in restoring or reestablishing corner:

G-5 Found a broken Standard Kent County Monument 5.6' North of the C/L of 14 Mile Road (bit.) (M-57) running East and West, 2' West of the C/L of Myers Lake Avenue (bit.) running North, and on the C/L of Myers Lake Avenue extended running South per L.C.R.C.'s #3044 and #4833 as set by Rob Jonker in place of a 3/4" x 20" solid iron he found in a monument box which checked L.C.R.C. #1394.

L.C.R.C. #3044

Remon. tag on SE side light pole N45°E 61.20'
Remon. tag on SE side light pole S40°W 72.20'
Chisled "X" on curb joint N35°W 47.25'
Chisled "X" on curb joint S40°W 56.03'
C/L E-W pvt. N 6'm/
On C/L to N and 2'W of C/L to South

L.C.R.C. #4833

Remon tag & nail on SE sde L pole N 45 E 61.20' (m. 61.17')
Remon tag & nail on SE sde L pole S 40 W 72.20' (m. 72.15')
P.K. nail in curb joint N 35 W 47.25' (m. 46.72')
P.K. nail in curb joint S 40 W 56.03' (m. 52.95')
C/L E-W pvt. S 5.6' M/L
On C/L to N & 2' W of C/L to S

The selected location is accepted by me and is generally accepted by professional surveyors as the best available evidence of the position of the original corner.

C. Description of monument for corner and accessories established to perpetuate locating the position of the corner:

G-5 Reset a Standard Kent County Monument


Nail & K.C. remon. tag on SE side U. pole N 45° E 61.17'
Nail & K.C. remon. tag on SE side U. pole S 40° W 72.15'
"X" cut top conc. culvert (N end) N 65° E 108.24'
"X" cut top conc. culvert (S end) S 67° E 113.68'
"X" cut top conc. culvert (S end) S 60° W 116.66'
"X" cut top conc. culvert (N end) N 75° W 106.12'
C/L of bit. road running E-W, South 5.6'
C/L of bit. road running N, East 2'
On C/L of bit road extended running S

P.A. 345 1990 KENT COUNTY

PEER APPROVED

CHAIRMAN

[Signature]
2/25/99

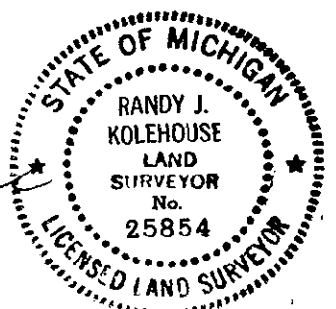

Signed by *[Signature]*

Date 3/30/99

EARTH TECH

Surveyor's Michigan License No. 25854