

MAY 28 2000

SECTION

LAND CORNER RECORDATION CERTIFICATE
Filing Requirement of Act 74, Mich. P.A. 1970
KENT COUNTY REMONUMENTATION

For corners in

Table with columns: Kent (County), Located in: Courtland Township, Corner Code #. Rows include Public Land Survey, Property Controlling in Section, Miscellaneous Property in Sec.

REG. OF DEEDS

Handwritten signature


STATE OF MICHIGAN
COUNTY OF KENT
RECEIVED FOR RECORD
1999 OCT 15 AM 8:05

11321

Register of Deeds Stamp & File Number

- 4. Lot No. , Recorded Plat
5. Private Claims

I, Randy Kolehouse, in a field survey on January 21 19 99, do hereby certify that under requirements of P.A. 74 Michigan P.A. of 1970, the corner points mentioned in lines 1 and 2 above were in conformance with regulations and rules therefore as required in the current manual of survey instructions of the United States Department of the interior, Bureau of Land Management or by a decree of a Court of Law and/or that the corner points mentioned in lines 3, 4 and 5 above were in conformance with the rules of the Michigan Board of Land Surveyors or by a Decree of a Court of Law; established, re-established, monumented, re-monumented, recovered, found as expressed below:

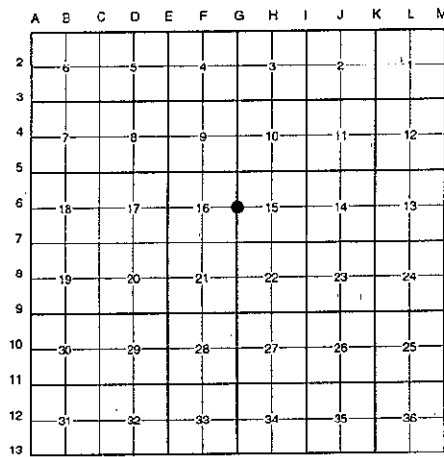

NOTE: Not more than 4 corners, all in the same town and range, may be recorded on this certificate.

A. Description of original monument and accessories and/or subsequent restoration:

Table with columns: G-6, Date, Description, Surveyor, Monument Type. Includes entries for 1837, 1963, 1980, 1982, 1988.

This corner was originally approved by the Kent County Remonumentation Peer Group and monumented by Rob Jonker on 9/2/80 and was recorded per L.C.R.C. #3059.

B. Description of corner evidence found and/or method applied in restoring or reestablishing corner:

G-6 Found a Standard Kent County Monument in a monument box on the C/L of Myers Lake Avenue (bit.) running North and South, on line of a tree row running East and West, per L.C.R.C.'s #3059 and #4834 as set by Rob Jonker in place of a 1/2" iron he found in a monument box which checked L.C.R.C. #1394 and the K.C. Surveyor's records.

L.C.R.C. #3059

L.C.R.C. #4834

Remon. tag on W side 18" Oak S30°E 59.07'
Remon. tag on N side 36" Oak S70°E 34.38'
Remon. tag on S side p.pole N55°E 33.02'
On C/L N-S pvt.
On E-W tree lines


Remon tag & nail on W sde 20" Oak S 30 E 59.09' (m. 59.20')
Remon tag & nail on N sde 38" Oak S 70 E 34.38' (m. 34.40')
Remon tag & nail on S sde P pole N 55 E 33.02' (m. 33.04')
On C/L N-S pvt.
On E-W tree lines

The selected location is accepted by me and is generally accepted by professional surveyors as the best available evidence of the position of the original corner.

C. Description of monument for corner and accessories established to perpetuate locating the position of the corner:

G-6 Standard Kent County Monument in a Monument Box
Nail & K.C. remon. tag on W side 22" Oak S 30° E 59.20'
Nail & K.C. remon. tag on N side 38" Oak S 70° E 34.40'
Nail & K.C. remon. tag on S side P. pole N 55° E 33.04'
Nail & K.C. remon. tag on S side 40" Cherry West 137.18'
On C/L of bit. road running N-S
On tree row running E-W

P.A. 345 1990 KENT COUNTY
PEER APPROVED 2/29/99
CHAIRMAN Randy Kolehouse

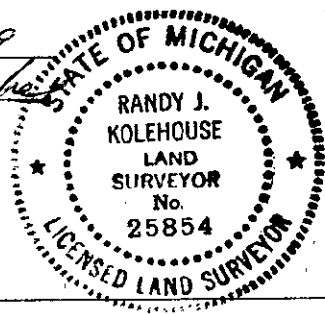

Signed by Randy J. Kolehouse
EARTH TECH

Date 3/30/99

Surveyor's Michigan License No. 25854