

MAY 22 2000

7/2

SECTION

LAND CORNER RECORDATION CERTIFICATE
Filing Requirement of Act 74, Mich. P.A. 1970
KENT COUNTY REMONUMENTATION

For corners in

Kent (County)	Located in:	Courtland Township	Corner Code #
1. Public Land Survey	T <u>9N</u>	R <u>10W</u>	<u>G-7</u>
	T _____	R _____	_____
	T _____	R _____	_____
	T _____	R _____	_____
2. Property Controlling in Section	S _____	T _____	R _____
	S _____	T _____	R _____
3. Miscellaneous Property in Sec.	S _____	T _____	R _____
	S _____	T _____	R _____

4. Lot No. _____, Recorded Plat _____
5. Private Claims _____

REG. OF DEEDS

[Signature]


STATE OF MICHIGAN
COUNTY OF KENT
RECEIVED FOR RECORD
1999 OCT 15 AM 8:05

11322

Register of Deeds Stamp & File Number

I, Randy Kolehouse, in a field survey on January 8 19 99, do hereby certify that under requirements of P.A. 74 Michigan P.A. of 1970, the corner points mentioned in lines 1 and 2 above were in conformance with regulations and rules therefore as required in the current manual of survey instructions of the United States Department of the Interior, Bureau of Land Management or by a decree of a Court of Law and/or that the corner points mentioned in lines 3, 4 and 5 above were in conformance with the rules of the Michigan Board of Land Surveyors or by a Decree of a Court of Law; established, re-established, monumented, re-monumented, recovered, found as expressed below:

NOTE: Not more than 4 corners, all in the same town and range, may be recorded on this certificate.

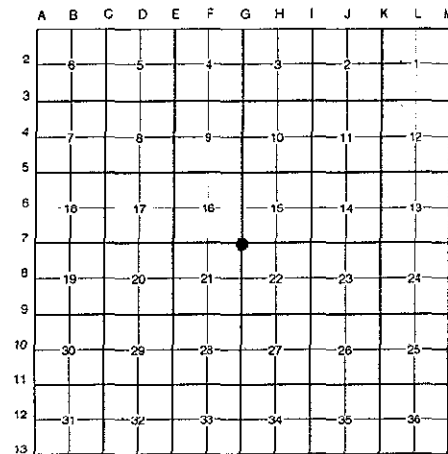

A. Description of original monument and accessories and/or subsequent restoration:

G-7	1837	G.L.O. Notes	Cathcart	Set Post
	1947	Witness Map	K.C. Surveyor	1/2" Bolt
	1980	L.C.R.C. #1394	Moore & Bruggink	1" Iron in Monument Box
	1982	L.C.R.C. #3058	Jonker Land Survey	Fnd. 1" Iron / Set K.C. Monument in Mon. Box
	1988	L.C.R.C. #4835	Olson, Meyer & May	K.C. Monument in Mon. Box

This corner was originally approved by the Kent County Remonumentation Peer Group and monumented by Rob Jonker on 7/28/82 and was recorded per L.C.R.C. #3058.

B. Description of corner evidence found and/or method applied in restoring or reestablishing corner:

G-7 Found a Standard Kent County Monument at the C/L intersection of 13 Mile Road (bit.) running East and West and Myers Lake Avenue (bit.) running North and South per L.C.R.C.'s #3058 and #4835 as set by Rob Jonker in place of a 1" solid iron he found in a monument box over a 1/2" bolt 1.0' below grade which checked L.C.R.C. #1394 and the K.C. Surveyor's records.

L.C.R.C. #3058

SW cor. house fnd. N50°E 103.3'
Remon. tag on N side 20" Maple S80°W 152.52'
Remon. tag on E side g.pole S20°W 84.26'
Remon. tag on W side p.pole S15°E 77.71'

L.C.R.C. #4835

SW cor hse fndn N 50 E 103.3' (m. 103.35')
Remon tag & nail on N sde 22" Maple S 80 W 152.52' (m. 152.54')
Remon tag & nail on E sde guy pole S 20 W 84.26' (m. 84.28')
Remon tag & nail on W sde P pole S 15 E 77.71' (m. 77.70')

The selected location is accepted by me and is generally accepted by professional surveyors as the best available evidence of the position of the original corner.


C. Description of monument for corner and accessories established to perpetuate locating the position of the corner:

G-7 Standard Kent County Monument

Nail & K.C. remon. tag on E side 36" Oak N 20° W 113.67' PEER APPROVED
Nail & K.C. remon. tag on W side P. pole S 15° E 77.70'
Nail & K.C. remon. tag on E side Guy pole S 20° W 84.28'
Nail & K.C. remon. tag on N side 24" Maple S 80° W 152.54'
SW cor. hse. fndn. N 50° E 103.35'
On C/L "X" of bit. roads running N-S & E-W

P.A. 345 1990 KENT COUNTY

CHAIRMAN *[Signature]*

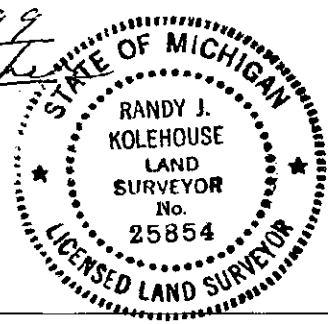

Signed by Randy J. Kolehouse

Date 3/30/99

Surveyor's Michigan License No. 25854