

7/2

MAY 22 2000

SECTION

LAND CORNER RECORDATION CERTIFICATE
Filing Requirement of Act 74, Mich. P.A. 1970
KENT COUNTY REMONUMENTATION

For corners in

Kent (County)	Located in:	Courtland Township	Corner Code #
1. Public Land Survey	T <u>9N</u>	R <u>10W</u>	<u>G-9</u>
	T _____	R _____	_____
	T _____	R _____	_____
	T _____	R _____	_____
2. Property Controlling in Section	S _____	T _____	R _____
	S _____	T _____	R _____
3. Miscellaneous Property in Sec.	S _____	T _____	R _____
	S _____	T _____	R _____

REG. OF DEEDS

[Signature]


STATE OF MICHIGAN
COUNTY OF KENT
RECEIVED FOR RECORD
1999 OCT 15 AM 8:05

11323

Register of Deeds Stamp & File Number

4. Lot No. _____, Recorded Plat _____
5. Private Claims _____

I, Randy Kolehouse, in a field survey on January 11 19 99, do hereby certify that under requirements of P.A. 74 Michigan P.A. of 1970, the corner points mentioned in lines 1 and 2 above were in conformance with regulations and rules therefore as required in the current manual of survey instructions of the United States Department of the interior, Bureau of Land Management or by a decree of a Court of Law and/or that the corner points mentioned in lines 3, 4 and 5 above were in conformance with the rules of the Michigan Board of Land Surveyors or by a Decree of a Court of Law; established, re-established, monumented, re-monumented, recovered, found as expressed below:

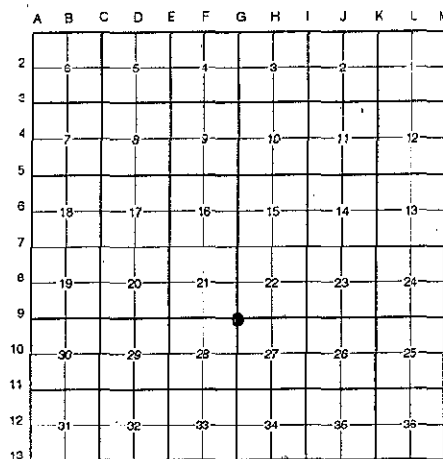

NOTE: Not more than 4 corners, all in the same town and range, may be recorded on this certificate.

A. Description of original monument and accessories and/or subsequent restoration:

G-9	1837	G.L.O. Notes	Cathcart	Set Post
	1930	Witness Map	K.C. Surveyor	Monument Box
	1983	L.C.R.C. #3410	Glaza & Associates	Iron in Monument Box
	1983	L.C.R.C. #3640	John Bueche	Fnd. 3/4" Iron in Mon. Box / Set K.C. Mon. in Mon. Box
	1988	L.C.R.C. #4836	Olson, Meyer & May	K.C. Monument in Mon. Box

This corner was originally approved by the Kent County Remonumentation Peer Group and monumented by John Bueche on 11/16/83 and was recorded per L.C.R.C. #3640.

B. Description of corner evidence found and/or method applied in restoring or reestablishing corner:

G-9 Found a Standard Kent County Monument in a monument box at the C/L intersection of 12 Mile Road (bit.) running West and Myers Lake Avenue (bit.) running North and South, on line of a tree row running East, per L.C.R.C.'s #3640 and #4836 as set by John Bueche in place of a 3/4" iron he found in a monument box which checked L.C.R.C. #3410 and the K.C. Surveyor's records.

L.C.R.C. #3640

L.C.R.C. #4836

- "X" cut on conc. curb N 20° W 59.58'
- "X" cut on conc. curb N 65° W 59.64'
- "X" cut on conc. curb S 65° W 59.32'
- "X" cut on conc. curb S 30° W 59.31'
- "X" on conc. culvert N 35° E 57.87'
- PK nail in Power Pole N 60° W 87.30'
- PK nail in Power Pole S 30° E 112.80'

- "X" cut on conc curb N 20 W 59.58' (m. 59.60')
- "X" cut on conc curb N 65 W 59.64' (m. 59.67')
- "X" cut on conc curb S 65 W 59.32' (m. 59.34')
- "X" cut on conc curb S 30 W 59.31'
- "X" cut on conc culvt N 35 E 57.87'
- PK nail in NE sde P pole N 60 W 87.30' (m. 87.16')
- PK nail in NE sde P pole S 30 E 112.80' (m. 112.75')

The selected location is accepted by me and is generally accepted by professional surveyors as the best available evidence of the position of the original corner.

C. Description of monument for corner and accessories established to perpetuate locating the position of the corner:

G-9 Standard Kent County Monument in a Monument Box

- Nail & K.C. remon. tag on NE side P. pole S 30° E 112.75'
- Nail & K.C. remon. tag on NE side P. pole N 60° W 87.16'
- "X" cut on conc. curb N 20° W 59.60'
- "X" cut on conc. curb N 65° W 59.67'
- "X" cut on conc. curb S 65° W 59.34'
- "X" cut on conc. curb S 30° W 59.31'

- "X" cut on conc. culvert N 35° E 57.87'
- On C/L "X" of bit. roads running N-S & W
- On tree row running E


P.A. 345 1990 KENT COUNTY

PEER APPROVED 2/25/99

CHAIRMAN [Signature]

Signed by [Signature]
EARTH TECH

Date 3/30/99

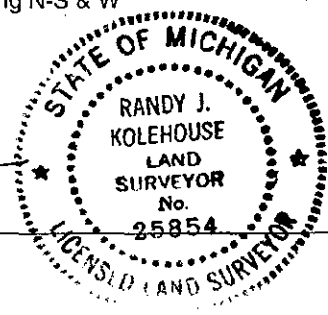

Surveyor's Michigan License No. 25854