

MAY 22 2000

7/2

SECTION

LAND CORNER RECORDATION CERTIFICATE
Filing Requirement of Act 74, Mich. P.A. 1970
KENT COUNTY REMONUMENTATION

For corners in

Table with columns: Kent (County), Located in: Courtland Township, Corner Code #. Rows include Public Land Survey, Property Controlling in Section, and Miscellaneous Property in Sec.

REG. OF DEEDS

Handwritten signature

STATE OF MICHIGAN
COUNTY OF KENT
RECEIVED FOR RECORD
1999 OCT 15 AM 8:05


11328

Register of Deeds Stamp & File Number

- 4. Lot No. Recorded Plat
5. Private Claims

I, Randy Kolehouse, in a field survey on January 5 19 99, do hereby certify that under requirements of P.A. 74 Michigan P.A. of 1970, the corner points mentioned in lines 1 and 2 above were in conformance with regulations and rules therefore as required in the current manual of survey instructions of the United States Department of the Interior, Bureau of Land Management or by a decree of a Court of Law and/or that the corner points mentioned in lines 3, 4 and 5 above were in conformance with the rules of the Michigan Board of Land Surveyors or by a Decree of a Court of Law; established, re-established, monumented, re-monumented, recovered, found as expressed below:

NOTE: Not more than 4 corners, all in the same town and range, may be recorded on this certificate.

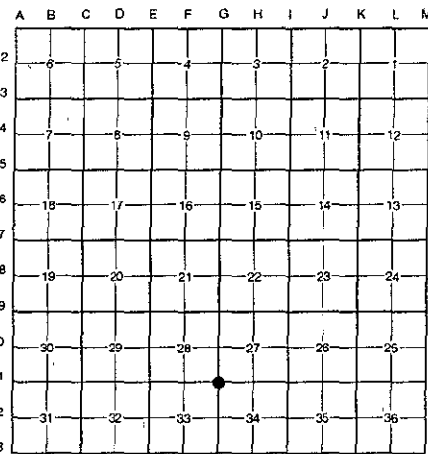

A. Description of original monument and accessories and/or subsequent restoration:

Table with columns: G-11, 1837, 1944, 1972, 1981, 1988; G.L.O. Notes, Witness Map, L.C.R.C. #223, L.C.R.C. #2577, L.C.R.C. #4837; Cathcart, K.C. Surveyor, Williams & Works, John Bueche, John Bueche; Set Post, Iron & Monument Box, Iron in Mon. Box, Fnd. 3/4" Iron in Mon. Box / Set K.C. Monument, K.C. Monument

This corner was originally approved by the Kent County Remonumentation Peer Group and monumented by John Bueche on 12/7/81 and was recorded per L.C.R.C. #2577.

B. Description of corner evidence found and/or method applied in restoring or reestablishing corner:

G-11 Found a Standard Kent County Monument on the C/L of 11 Mile Road (bit.) running East and West, on line of a tree row and fence line running North, per L.C.R.C.'s #2577 and #4837 as set by John Bueche in place of a 3/4" iron he found in a monument box which checked L.C.R.C. #223 and the K.C. Surveyor's records.

L.C.R.C. #2577

L.C.R.C. #4837

K.C. Remon. tag & nail in South side 18" Walnut N 80° E 99.82'
K.C. Remon. tag & nail in West side 12" Walnut N 0° E 45.02'
K.C. Remon. tag & nail in West side 8" Oak N 40° W 45.27'
K.C. Remon. tag & nail in North side Triple 8" Oak S 75° W 82.08'
NW cor. conc. porch S 15° W 96.94'
On C/L blkt. E & W
Fence & tree line North

K.C. Remon tag & nail in S sde 20" Walnut N 80 E 99.82' (m. 99.73')
K.C. Remon tag & nail in W sde 14" Walnut N 0 E 45.02' (m. 45.35')
K.C. Remon tag & nail in W sde 8" Oak N 40 W 45.20' (m. 45.08')
K.C. Remon tag & nail in N sde Triple 10" Oak S 75 W 82.08' (m. 82.02')
NW cor conc porch S 15 W 96.94' (m. 96.88')
On C/L bit E & W
Fence & tree line N

The selected location is accepted by me and is generally accepted by professional surveyors as the best available evidence of the position of the original corner.

C. Description of monument for corner and accessories established to perpetuate locating the position of the corner:


G-11 Standard Kent County Monument

Nail & K.C. remon. tag on S side 20" Walnut N 80° E 99.73'
Nail & K.C. remon. tag on W side 14" Walnut N 00° E 45.35'
Nail & K.C. remon. tag on W side 8" Oak N 40° W 45.08'
Nail & K.C. remon. tag on N side triple 10" Oak S 75° W 82.02'
NW cor. onc. Porch S 15° W 96.88'
On C/L of bit. road running E-W
On tree row and fence line running N

P.A. 345 1990 KENT COUNTY

PEER APPROVED

CHAIRMAN

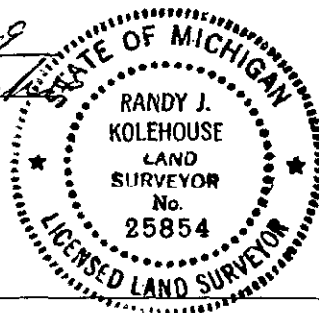

Signed by Randy J. Kolehouse

Date 3/30/99

Surveyor's Michigan License No. 25854