

MAY 22 2000

112

SECTION

LAND CORNER RECORDATION CERTIFICATE  
Filing Requirement of Act 74, Mich. P.A. 1970  
KENT COUNTY REMONUMENTATION

For corners in

Kent (County)	Located in:	Courtland Township	Corner Code #
1. Public Land Survey	T 9N	R 10W	G-12
	T	R	
	T	R	
	T	R	
2. Property Controlling in Section	S	T	R
	S	T	R
3. Miscellaneous Property in Sec.	S	T	R
	S	T	R

REG. OF DEEDS

*[Signature]*

STATE OF MICHIGAN  
COUNTY OF KENT  
RECEIVED FOR RECORD  
1999 OCT 15 AM 8:05


11329

Register of Deeds Stamp & File Number

- 4. Lot No. \_\_\_\_\_, Recorded Plat \_\_\_\_\_
- 5. Private Claims \_\_\_\_\_

I, Randy Kolehouse, in a field survey on February 18 19 99, do hereby certify that under requirements of P.A. 74 Michigan P.A. of 1970, the corner points mentioned in lines 1 and 2 above were in conformance with regulations and rules therefore as required in the current manual of survey instructions of the United States Department of the Interior, Bureau of Land Management or by a decree of a Court of Law and/or that the corner points mentioned in lines 3, 4 and 5 above were in conformance with the rules of the Michigan Board of Land Surveyors or by a Decree of a Court of Law; established, re-established, monumented, re-monumented, recovered, found as expressed below:

**NOTE: Not more than 4 corners, all in the same town and range, may be recorded on this certificate.**

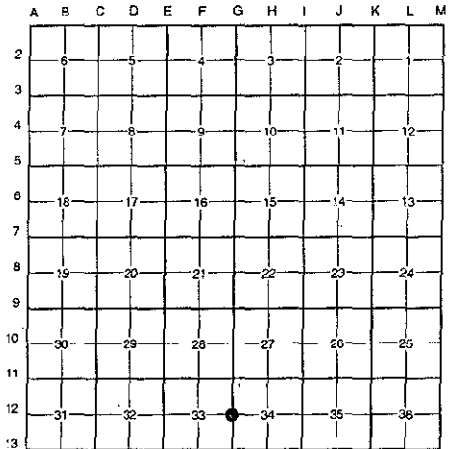

A. Description of original monument and accessories and/or subsequent restoration:

G-12	1837	G.L.O. Notes	Cathcart	Set Post
	1900-49	Notes	Williams & Works	Stone
	1972	Survey	Donker	Stone
	1989	L.C.R.C. #5303	Kevin Roosien	Fnd. Stone / Set Capped Rerod
	1995	L.C.R.C. #8709	Kirk Breitels	Fnd. Capped Rerod / Set K.C. Monument

This corner was originally approved by the Kent County Remonumentation Peer Group and monumented by Kirk Breitels on 6/26/95 and was recorded per L.C.R.C. #8709.

B. Description of corner evidence found and/or method applied in restoring or reestablishing corner:

G-12 Found a Standard Kent County Monument on line of a tree row and fence line running East and West per L.C.R.C. #8709 as set by Kevin Roosien in place of a capped rerod he found surrounded by stones which checked L.C.R.C. #5303, the 1972 survey by Donker and the 1900-1949 notes of Williams & Works.

L.C.R.C. #8709

- Nail & KC Remon. tag E. side 10' Cherry S00°W 6.72' (m. 6.73')
- Nail & KC Remon. tag N. side 10' Oak S65°E 5.90' (m. 5.89')
- Nail & KC Remon. tag N. side 12' Cherry S80°E 33.71' (m. 33.72')
- Nail & KC Remon. tag S. side 12' Oak S90°W 31.10'

The selected location is accepted by me and is generally accepted by professional surveyors as the best available evidence of the position of the original corner.


C. Description of monument for corner and accessories established to perpetuate locating the position of the corner:

- G-12 Standard Kent County Monument
- Nail & K.C. remon. tag on E side 10" Cherry South 6.73'
- Nail & K.C. remon. tag on N side 10" Oak S 65° E 5.89'
- Nail & K.C. remon. tag on N side 12" Cherry S 80° E 33.72'
- Nail & K.C. remon. tag on S side 12" Oak West 31.10'
- SW cor. frame to hse. #7200 N 10° W 109.43'
- On tree row and fence line running E-W

P.A. 345 1990 KENT COUNTY

PEER APPROVED 2/25/99

CHAIRMAN *[Signature]*

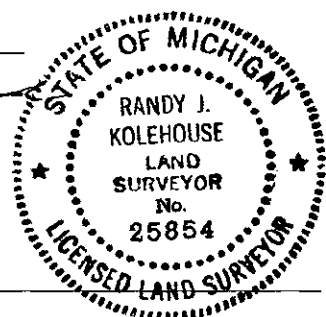

Signed by *Randy J. Kolehouse*  
EARTH TECH

Date 3/30/99

Surveyor's Michigan License No. 25854