

MAY 22 2000

SECTION

LAND CORNER RECORDATION CERTIFICATE  
Filing Requirement of Act 74, Mich. P.A. 1970  
KENT COUNTY REMONUMENTATION

For corners in

Kent (County)	Located in:	Courtland Township	Corner Code #
1. Public Land Survey	T <u>9N</u>	R <u>10W</u>	<u>H-1</u>
	T _____	R _____	_____
	T _____	R _____	_____
	T _____	R _____	_____
2. Property Controlling in Section	S _____	T _____	R _____
	S _____	T _____	R _____
3. Miscellaneous Property in Sec.	S _____	T _____	R _____
	S _____	T _____	R _____

REG. OF DEEDS

*[Signature]*

STATE OF MICHIGAN  
COUNTY OF KENT  
RECEIVED FOR RECORD  
1999 OCT 15 AM 8:05


11330

Register of Deeds Stamp & File Number

4. Lot No. \_\_\_\_\_, Recorded Plat \_\_\_\_\_  
5. Private Claims \_\_\_\_\_

I, Randy Kolehouse, in a field survey on February 16 19 99, do hereby certify that under requirements of P.A. 74 Michigan P.A. of 1970, the corner points mentioned in lines 1 and 2 above were in conformance with regulations and rules therefore as required in the current manual of survey instructions of the United States Department of the interior, Bureau of Land Management or by a decree of a Court of Law and/or that the corner points mentioned in lines 3, 4 and 5 above were in conformance with the rules of the Michigan Board of Land Surveyors or by a Decree of a Court of Law; established, re-established, monumented, re-monumented, recovered, found as expressed below:

**NOTE: Not more than 4 corners, all in the same town and range, may be recorded on this certificate.**

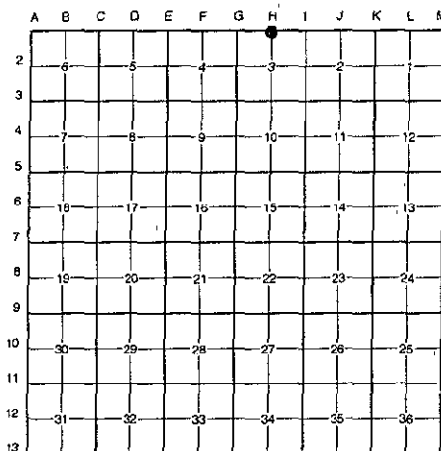

A. Description of original monument and accessories and/or subsequent restoration:

H-1	1837	G.L.O. Notes	Cathcart	Set Post
	1898	Notes	Williams & Works	Stake
	1985	L.C.R.C. #4139	C. Hay	Set Iron on Township Line
	1986	L.C.R.C. #4438	R. Kolehouse	Fnd. 1" Iron / Set K.C. Monument
	1988	L.C.R.C. #4792	John Bueche	K.C. Monument

Note: This corner is not common with H-13, T10N, R10W.

This corner was originally approved by the Kent County Remonumentation Peer Group and monumented by Randy Kolehouse in May of 1986 and was recorded per L.C.R.C. #4438.

B. Description of corner evidence found and/or method applied in restoring or reestablishing corner:

H-1 Found a Standard Kent County Monument in a swamp on the easterly extension of the C/L of 16 Mile Road (gravel) running West and old roadbed running East and South per L.C.R.C.'s #4438 and #4792 as set by Randy Kolehouse in place of a 1" iron he found on the Township line which checked L.C.R.C. #4139 and the 1898 notes of Williams & Works.

L.C.R.C. #4438

L.C.R.C. #4792

C/L 4" steel Gas route marker S 80° W 20.89'  
K.C. Monument at S 1/4 cor. sec. 34 T 10 N R 10 W West 120.25'

C/L 4" steel Gas route marker S 80 W 20.89' (m. 20.93')  
K.C. Mon at S 1/4 cor. sec. 34, T10N, R 10W, W 120.25'


The selected location is accepted by me and is generally accepted by professional surveyors as the best available evidence of the position of the original corner.

C. Description of monument for corner and accessories established to perpetuate locating the position of the corner:

H-1 Standard Kent County Monument  
C/L 4" steel gas route marker S 80° W 20.93'  
Nail & K.C. remon. tag on SW side 6" Ash N 35° W 26.85'  
Nail & K.C. remon. tag on N side 14" Elm (5' up) N 75° W 53.43'  
Nail & K.C. remon. tag on W side 10" Poplar (3' up) S 25° E 30.81'  
On C/L of bit. road extended running E (in swamp)  
K.C. Mon., H-13, T10N, R10W, West 120.25'

P.A. 345 1990 KENT COUNTY

PEER APPROVED 2/25/99  
CHAIRMAN [Signature]

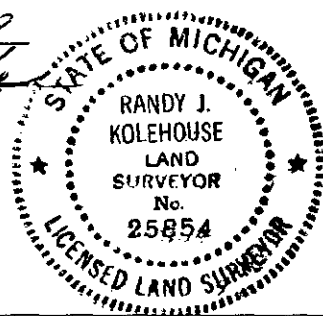

Signed by Randy J. Kolehouse  
EARTH TECH

Date 3/31/99

Surveyor's Michigan License No. 25854