

MAY 22 2000

7/2

SECTION

LAND CORNER RECORDATION CERTIFICATE
Filing Requirement of Act 74, Mich. P.A. 1970
KENT COUNTY REMONUMENTATION

For corners in

Kent (County)	Located in: Courtland Township	Corner Code #
1. Public Land Survey	T <u>9N</u> R <u>10W</u>	<u>H-3</u>
	T _____ R _____	_____
	T _____ R _____	_____
	T _____ R _____	_____
2. Property Controlling in Section	S _____ T _____ R _____	_____
	S _____ T _____ R _____	_____
3. Miscellaneous Property in Sec.	S _____ T _____ R _____	_____
	S _____ T _____ R _____	_____

REG. OF DEEDS

11331

Register of Deeds Stamp & File Number


1999 OCT 15 AM 8:05

STATE OF MICHIGAN
COUNTY OF KENT
RECEIVED FOR RECORD

- 4. Lot No. _____, Recorded Plat _____
- 5. Private Claims _____

I, Randy Kolehouse, in a field survey on February 15 19 99, do hereby certify that under requirements of P.A. 74 Michigan P.A. of 1970, the corner points mentioned in lines 1 and 2 above were in conformance with regulations and rules therefore as required in the current manual of survey instructions of the United States Department of the interior, Bureau of Land Management or by a decree of a Court of Law and/or that the corner points mentioned in lines 3, 4 and 5 above were in conformance with the rules of the Michigan Board of Land Surveyors or by a Decree of a Court of Law; established, re-established, monumented, re-monumented, recovered, found as expressed below:

NOTE: Not more than 4 corners, all in the same town and range, may be recorded on this certificate.

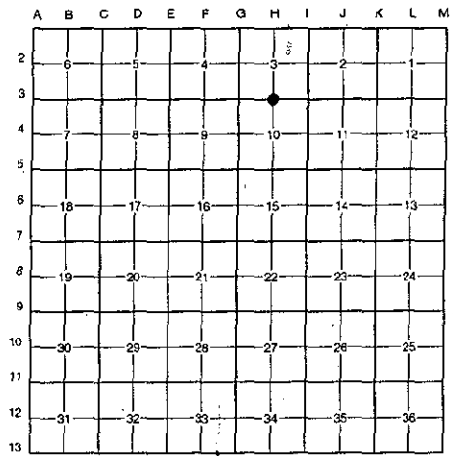

A. Description of original monument and accessories and/or subsequent restoration:

H-3	1837	G.L.O. Notes	Cathcart	Set Post
	1939-63	Witness Map	K.C. Surveyor	Concrete Monument
	1979	L.C.R.C. #1287	R. Crater	3/4" Pipe
	1982	L.C.R.C. #3057	Jonker Land Survey	Fnd. 3/4" Iron Over Broken Conc. Mon. / Set K.C. Monument
	1991	L.C.R.C. #6260	C. Marschall	K.C. Monument

This corner was originally approved by the Kent County Remonumentation Peer Group and monumented by Rob Jonker on 8/4/82 and was recorded per L.C.R.C. #3057.

B. Description of corner evidence found and/or method applied in restoring or reestablishing corner:

H-3 Found a Standard Kent County Monument 3.0' West of the C/L intersection of Berrigan Avenue (gravel) running South and 15 Mile Road (bit.) running East and West and per L.C.R.C.'s #3057 and 6260 as set by Rob Jonker in place of a 3/4" iron he found over a broken 4" x 24" concrete monument 12" below grade which checked L.C.R.C. #1287 and the K.C. Surveyor's records.

L.C.R.C. #3057	L.C.R.C. #6260
Remon. tag on SE side 12" Oak N45°E 38.68'	Nail & Remon tag in NE side 10" Cherry N 52 W 64.03' (m. 64.00')
Remon. tag on SE side p.pole S40°W 158.0'	Nail & Remon tag in W side 18" Oak N 39 E 38.14' (m. 38.14')
Remon. tag on N side 4" tw. Oak S70°E 100.0'	Nail & Remon tag in N side 10" Twin Oak S 73 E 100.05'
On C/L E-W pvt.	Nail & Remon tag in W side 12" Wood Post S 23 E 79.81' (m. 79.97')
C/L gravel to South, 3'E	Nail & Remon tag in SE side P.P. S 33 W 158.16' (m. 158.14')

The selected location is accepted by me and is generally accepted by professional surveyors as the best available evidence of the position of the original corner.


C. Description of monument for corner and accessories established to perpetuate locating the position of the corner:

- H-3 Standard Kent County Monument
- Nail & K.C. remon. tag on NE side 12" Cherry N 52° W 64.00'
 - Nail & K.C. remon. tag on W side 20" Oak N 39° E 38.14'
 - Nail & K.C. remon. tag on N side 12" twin Oak S 73° E 100.05'
 - Nail & K.C. remon. tag on SE side 12" wood post S 23° E 79.97'
 - Nail & K.C. remon. tag on SE side P. pole S 33° W 158.14'
 - On C/L of bit. road running E-W
 - C/L of gravel road running S, East 3.0'

P.A. 345 1990 KENT COUNTY

PEER APPROVED 2/25/99

CHAIRMAN [Signature]

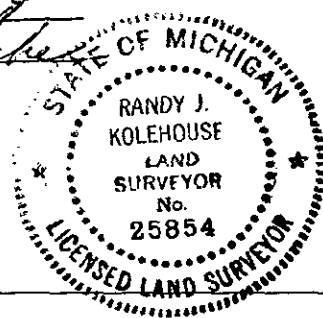

Signed by Randy J. Kolehouse
EARTH TECH

Date 3/30/99

Surveyor's Michigan License No. 25854