SURVEY & REMONUMENTATION COMMISSION

$7.00
$2.00

SEP 18 1995

KENT COUNTY REMONUMENTATION

LAND CORNER RECORDATION CERTIFICATE
Filing Requirement of Act 74, Mich. P.A. 1970

STATE OF MICHIGAN
COUNTY OF KENT
RECEIVED FOR RECORD
95 JUL 11 PM 1:53
REG. OF DEEDS
8528
Register of Deeds Stamp & File Number

For corners in KENT COUNTY (County)

	Located In:	Corner Code #
1. Public Land Survey	T 9N R 10W	H-4
	T ___ R ___	
	T ___ R ___	
	T ___ R ___	
2. Property Controlling	S ___ T ___ R ___	
in Section	S ___ T ___ R ___	
3. Miscellaneous	S ___ T ___ R ___	
Property in Section	S ___ T ___ R ___	

4. Lot No. _____, Recorded Plat _____
5. Private Claims _____

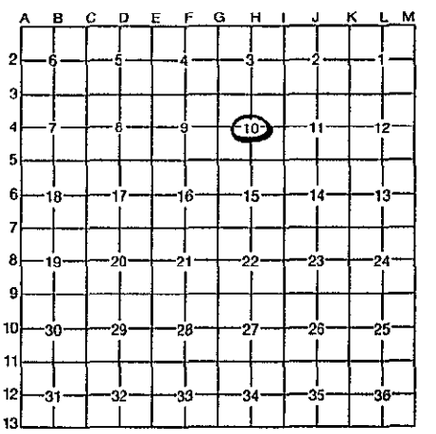

I, Kirk Breitels, in a field survey on June 29, 19 95, do hereby certify that under requirements of P.A. 74, Michigan P.A. of 1970, the corner points mentioned in lines 1 and 2 above were in conformance with regulations and rules therefore as required in the current manual of survey instructions of the United States Department of the Interior, Bureau of Land Management or by a decree of a Court of Law and/or that the corner points mentioned in lines 3, 4 and 5 above were in conformance with the rules of the Michigan Board of Professional Surveyors or by a Decree of a Court of Law; established, re-established, monumented, re-monumented, recovered, found as expressed below:

NOTE: Not more than 4 corners, all in the same town and range, may be recorded on this certificate.

A. Description of original monument and accessories and/or subsequent restoration:

H-4 1837 GLO Not Set

B. Description of corner evidence found and/or method applied in restoring or reestablishing corner:
H-4 Found 1" x 18" Iron Pipe 0.1' W. & 1.0' S. of true "X" of 1/4 lines. Said Iron Pipe has been used in a few surveys by various surveyors.

The Iron Pipe is accepted by me and is generally accepted by professional surveyors as the best available evidence of the position of the corner.

P.A. 345 1990 KENT COUNTY
PEER APPROVED 6/22/95
CHAIRMAN Harry Huber

C. Description of monument for corner and accessories established to perpetuate locating the position of the corner:

H-4 Set Standard Kent County Monument in place of the Iron Pipe.

Set Nail & KC Remon. tag E. side 15" Maple	N25°W	62.10'
Set Nail & KC Remon. tag NW side P. Pole	S60°E	75.78'
Set Nail & KC Remon. tag NE side 8" Tree	S35°E	50.21'
NE cor. porch siding	N55°W	98.03'
Iron Pipe	S35°W	61.20'
Capped Re-rod (All Points)	East	33.03'
C\L Grav. Rd. N-S is East 3' m/l		

STATE OF MICHIGAN
KIRK BREITELS
LAND SURVEYOR
NO 30077
LICENSED LAND SURVEYOR

Signed by Kirk Breitels Date 7/6/95

Surveyor's Michigan License No. 30077

FORM APPROVED BY MICHIGAN STATE BOARD OF PROFESSIONAL SURVEYORS, JAN. 28, 1971
REVISED MAY 14, 1975
REVISED JAN., 1983