$7.00
$2.00

SEP 18 1995

KENT COUNTY REMONUMENTATION

LAND CORNER RECORDATION CERTIFICATE

Filing Requirement of Act 74, Mich. P.A. 1970

For corners in KENT COUNTY (County)

STATE OF MICHIGAN
COUNTY OF KENT
RECEIVED FOR RECORD
95 JUL 11 PM 1:53
REG. OF DEEDS
8529
Register of Deeds Stamp & File Number

	Located In:	Corner Code #
1. Public Land Survey	T 9N R 10W	H-6
	T ___ R ___	
	T ___ R ___	
	T ___ R ___	
2. Property Controlling	S ___ T ___ R ___	
In Section	S ___ T ___ R ___	
3. Miscellaneous	S ___ T ___ R ___	
Property in Section	S ___ T ___ R ___	

4. Lot No. _____, Recorded Plat _____
5. Private Claims _____

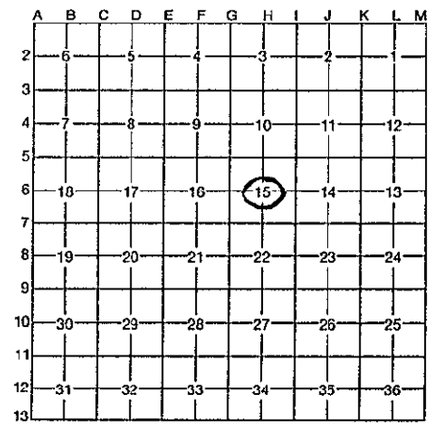

I, Kirk Breitels, in a field survey on June 29, 19 95, do hereby certify that under requirements of P.A. 74, Michigan P.A. of 1970, the corner points mentioned in lines 1 and 2 above were in conformance with regulations and rules therefore as required in the current manual of survey instructions of the United States Department of the Interior, Bureau of Land Management or by a decree of a Court of Law and/or that the corner points mentioned in lines 3, 4 and 5 above were in conformance with the rules of the Michigan Board of Professional Surveyors or by a Decree of a Court of Law; established, re-established, monumented, re-monumented, recovered, found as expressed below:

NOTE: Not more than 4 corners, all in the same town and range, may be recorded on this certificate.

A. Description of original monument and accessories and/or subsequent restoration:

H-6 1837 GLO Not Set

B. Description of corner evidence found and/or method applied in restoring or reestablishing corner:

H-6 Found Rerod 0.4' W. & 0.6' S. of true "X" of 1/4 lines. Said Rerod has been used in many surveys by various surveyors.

The Rerod is accepted by me and is generally accepted by professional surveyors as the best available evidence of the position of the corner.

P.A. 345 1990 KENT COUNTY
PEER APPROVED 6/22/95
CHAIRMAN [signature]

C. Description of monument for corner and accessories established to perpetuate locating the position of the corner:

H-6 Set Standard Kent County Monument in place of the Rerod.
Set Nail & KC Remon. tag SW side 15" Maple S35°E 34.77'
Set Nail & KC Remon. tag NW side 40" Maple N50°E 28.93'
Set Nail & KC Remon. tag SW side 30" Maple N35°W 59.28'
Set Nail & KC Remon. tag S. side 36" Maple S90°W 27.65'
Set Nail & KC Remon. tag SE side 36" Maple S40°W 54.19'
C/L Asph. Rd. N-S is West 3'

STATE OF MICHIGAN
KIRK BREITELS
LAND SURVEYOR
NO 30077
LICENSED LAND SURVEYOR

Signed by [signature] Date 7/6/95

Surveyor's Michigan License No. 30077

FORM APPROVED BY MICHIGAN STATE BOARD OF PROFESSIONAL SURVEYORS, JAN. 28, 1971
REVISED MAY 14, 1975
REVISED JAN., 1983