

MAY 28 2000

SECTION

LAND CORNER RECORDATION CERTIFICATE
Filing Requirement of Act 74, Mich. P.A. 1970
KENT COUNTY REMONUMENTATION

For corners in

Table with columns: Kent (County), Located in: Courtland Township, Corner Code #. Rows include Public Land Survey, Property Controlling in Section, and Miscellaneous Property in Sec.

REG. OF DEEDS

Handwritten signature/initials

STATE OF MICHIGAN
COUNTY OF KENT
RECEIVED FOR RECORD
1999 OCT 15 AM 8:05

11333

Register of Deeds Stamp & File Number


- 4. Lot No.
5. Private Claims

I, Randy Kolehouse, in a field survey on January 18 19 99, do hereby certify that under requirements of P.A. 74 Michigan P.A. of 1970, the corner points mentioned in lines 1 and 2 above were in conformance with regulations and rules therefore as required in the current manual of survey instructions of the United States Department of the Interior, Bureau of Land Management or by a decree of a Court of Law and/or that the corner points mentioned in lines 3, 4 and 5 above were in conformance with the rules of the Michigan Board of Land Surveyors or by a Decree of a Court of Law; established, re-established, monumented, re-monumented, recovered, found as expressed below:

NOTE: Not more than 4 corners, all in the same town and range, may be recorded on this certificate.

A. Description of original monument and accessories and/or subsequent restoration:

Table with columns: H-7, 1837, G.L.O. Notes, Cathcart, Set Post, N/A, Witness Map, K.C. Surveyor, Iron, 1980, L.C.R.C. #1395, C. Shangraw, 1-1/2" Iron, 1982, L.C.R.C. #3055, Jonker Land Survey, Fnd. 1/4" Spike / Set K.C. Monument, 1991, L.C.R.C. #6257, C. Marschall, Reset K.C. Monument

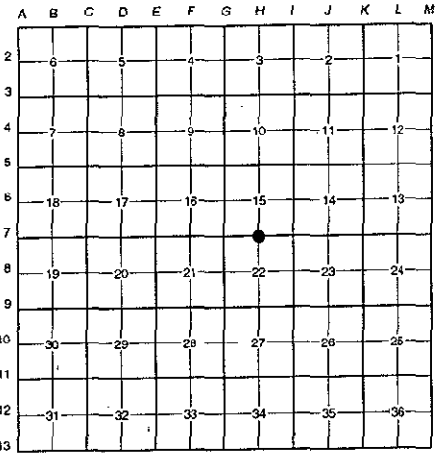

This corner was originally approved by the Kent County Remonumentation Peer Group and monumented by Rob Jonker on 7/28/82 and was recorded per L.C.R.C. #3055.

B. Description of corner evidence found and/or method applied in restoring or reestablishing corner:

H-7 Found a Standard Kent County Monument 3.0' East of the C/L intersection of Berrigan Avenue (bit.) running North and 13 Mile Road (bit.) running East and West per L.C.R.C.'s #3055 and #6257 as set by Rob Jonker in place of a 1/4" x 2-1/2" spike he found at grade over a 1-1/2" iron 12" below grade which checked L.C.R.C. #1395 and as reset by C. Marschall in 1991.

L.C.R.C. #3055

L.C.R.C. #6257

Remon. tag on E side 40" Maple S05°W 127.4'
NE cor. twp. Hall S75°W 193.75'
C/L top MBT box S40°E 45.88'
On C/L E-W pvt. & 3'E of C/L gravel to North

Nail 7 Tag SE sd. Light Pole S 29 W 144.14'
Nail & Tag E sd. 50" Maple S 02 WS 127.17' (m. 127.07')
NE corner Twp. Hall Fnd. S 72 W 193.67'
C/L top MBT Box S 45 E 45.76' m. 45.80')
On C/L E-W Pvt. And more or less 3'E of C/L gravel to North

The selected location is accepted by me and is generally accepted by professional surveyors as the best available evidence of the position of the original corner.

C. Description of monument for corner and accessories established to perpetuate locating the position of the corner:


H-7 Standard Kent County Monument

Nail & K.C. remon. tag on SE side Light pole S 29° W 144.14'
Nail & K.C. remon. tag on E side 50" Maple S 02° W 127.07'
NE cor. fndn. Twp. Hall S 72° W 193.67'
C/L top MBT box S 45° E 45.80'
"X" cut top C/L E end 18" conc. culv. N 20° E 72.97'
"X" cut top C/L W end 18" conc. culv. N 15° W 76.51'
On C/L of bit. road running E-W
C/L of bit. road running N, West 3.0'

P.A. 345 1990 KENT COUNTY

PEER APPROVED 2/25/99

CHAIRMAN [Signature]

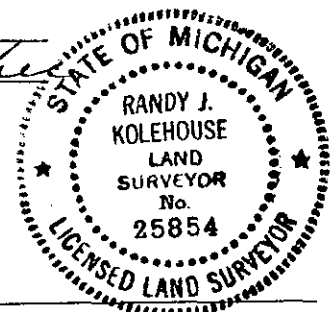

Signed by [Signature] EARTH TECH

Date 3/3/99

Surveyor's Michigan License No. 25854