

KENT COUNTY REMONUMENTATION

\$7.00
\$2.00

JAN 24 1996

COMMISSION LAND CORNER RECORDATION CERTIFICATE
Filing Requirement of Act 74, Mich. P.A. 1970

For corners in
KENT COUNTY
(County)

Located In: Corner Code #

- 1. Public Land Survey T 9N R 10W H-8
- T _____ R _____
- T _____ R _____
- T _____ R _____
- 2. Property Controlling S _____ T _____ R _____
- in Section S _____ T _____ R _____
- 3. Miscellaneous S _____ T _____ R _____
- Property in Section S _____ T _____ R _____
- 4. Lot No. _____, Recorded Plat _____
- 5. Private Claims _____

REG. OF DEEDS

95 SEP 14 PM 12:35

STATE OF MICHIGAN
COUNTY OF KENT
RECEIVED FOR RECORD

8706

Register of Deeds Stamp & File Number

| | | | | | | | | | | | | |
|----|----|----|----|----|----|----|---|---|---|---|---|---|
| A | B | C | D | E | F | G | H | I | J | K | L | M |
| 2 | 6 | 5 | 4 | 3 | 2 | 1 | | | | | | |
| 3 | | | | | | | | | | | | |
| 4 | 7 | 8 | 9 | 10 | 11 | 12 | | | | | | |
| 5 | | | | | | | | | | | | |
| 6 | 18 | 17 | 16 | 15 | 14 | 13 | | | | | | |
| 7 | | | | | | | | | | | | |
| 8 | 19 | 20 | 21 | 22 | 23 | 24 | | | | | | |
| 9 | | | | | | | | | | | | |
| 10 | 30 | 29 | 28 | 27 | 26 | 25 | | | | | | |
| 11 | | | | | | | | | | | | |
| 12 | 31 | 32 | 33 | 34 | 35 | 36 | | | | | | |
| 13 | | | | | | | | | | | | |

I, Kirk Breitels, in a field survey on Aug. 15, 1995, do hereby certify that under requirements of P.A. 74, Michigan P.A. of 1970, the corner points mentioned in lines 1 and 2 above were in conformance with regulations and rules therefore as required in the current manual of survey instructions of the United States Department of the Interior, Bureau of Land Management or by a decree of a Court of Law and/or that the corner points mentioned in lines 3, 4 and 5 above were in conformance with the rules of the Michigan Board of Professional Surveyors or by a Decree of a Court of Law; established, re-established, monumented, re-monumented, recovered, found as expressed below:

NOTE: Not more than 4 corners, all in the same town and range, may be recorded on this certificate.

A. Description of original monument and accessories and/or subsequent restoration:

- H-8 1837 GLO Not Set 1972 LCRC #292 VanKooten
- 1905 Williams & Works Stone 3/4" Iron in mon. box
- 1963 Kent Co. Wit. 18" Oak NNW 84.74'
- 1/2" Iron in mon. box 24" Oak SSE 82.70'
- 34" Oak WSW 49.95' 6" Tw. Cherry N 74.68'
- 30" Oak ESE 80.70' 1984 Survey Jonker
- 16" Oak NW 26.77' 3/4" Iron in mon. box
- 17" Oak WNW 84.20' 1992 Survey All Points
- (Measurements fit mon. box)

B. Description of corner evidence found and/or method applied in restoring or reestablishing corner:

H-8 Found 3/4" x 18" Iron Pipe inside a mon. box. Bottom of Iron is bent around a stone that is 14" below grade. Iron in mon. box is 0.2' S. and 8.9' E. of a true intersection of 1/4 lines.

Kent Co. Wit. LCRC #292
C/L 24" stump NW 85'± C/L 40" Oak SSE 83'±
C/L 12" Tw. Cherry N 75'±


Meas. W. to W 1/4 cor. Sec. 22 (Mon. Box) 2655.03' - 2655.0' Williams & Works 1905

The 3/4" Iron Pipe inside a mon. box over a stone is accepted by me and is generally accepted by professional surveyors as the best available evidence of the position of the corner.

C. Description of monument for corner and accessories established to perpetuate locating the position of the corner:

- H-8 Set Standard Kent County Monument inside a mon. box in place of 3/4" Iron Pipe.
- Set Nail & KC Remon. tag N. side 56" Oak S60°E 82.42'
- Set Nail & KC Remon. tag W. side 20" Cherry N00°E 74.49'
- Set Nail & KC Remon. tag S. side 12" Oak N75°W 82.47'
- Set Nail & KC Remon. tag N. side P. Pole S80°W 244.5'
- Capped Rerod (All Points) N00°E 32.95'

P.A. 345 1990 KENT COUNTY,
PEER APPROVED 8/24/95
CHAIRMAN Harry Huber

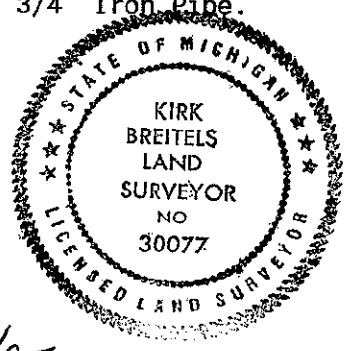

Signed by Kirk Breitels
30077

Date 9/8/95

Surveyor's Michigan License No. _____