

OCT 28 1994

COMMISSION

KENT COUNTY REMONUMENTATION
COURTLAND TWP.
LAND CORNER RECORDATION CERTIFICATE
Filing Requirement of Act 74, Mich. P.A. 1970

STATE OF MICHIGAN
COUNTY OF KENT
RECEIVED FOR RECORDING

94 JUL -5 PM 3:12

For corners in
KENT COUNTY

(County)	Located In:	Corner Code #/
1. Public Land Survey	T 9N R 10W	H-10 C 1/4 cor. Sec. 27
	T R	
	T R	
	T R	
2. Property Controlling in Section	S T R	
	S T R	
3. Miscellaneous Property in Sec.	S T R	
	S T R	

W. J. Bond
REG. OF DEEDS

6961

Register of Deeds Stamp & File Number

- 4. Lot No. _____, Recorded Plat _____
- 5. Private Claims _____

	A	B	C	D	E	F	G	H	I	J	K	L
2	6	5	4	3	2	1						
3												
4	7	8	9	10	11	12						
5												
6	18	17	16	15	14	13						
7												
8	19	20	21	22	23	24						
9												
10	30	29	28	27	26	25						
11												
12	31	32	33	34	35	36						
13												

I, William R. Byl, in a field survey on Feb. 8, 1994, do hereby certify that under requirements of P.A. 74, Michigan P.A. of 1970, the corner points mentioned in lines 1 and 2 above were in conformance with regulations and rules therefore as required in the current manual of survey instructions of the United States Department of the Interior, Bureau of Land Management or by a decree of a Court of Law and/or that the corner points mentioned in lines 3, 4 and 5 above were in conformance with the rules of the Michigan Board of Land Surveyors or by a Decree of a Court of Law, established, re-established, monumented, re-monumented, recovered, found as expressed below:

NOTE: Not more than 4 corners, all in the same town and range, may be recorded on this certificate.

A. Description of original monument and accessories and/or subsequent restoration:

H-10 3/4 Iron (LCRC #922, April 16, 1976)

10" Maple	N30°W	17.55'
18" Oak	S85°E	11.45'
14" Oak	S25°E	16.85'

B. Description of corner evidence found and/or method applied in restoring or reestablishing corner:

H-10 Found 3/4 Iron Pipe

Fd. Nail S. side 24" Oak	S85°E	11.37'
Fd. Nail E. side 16" Oak	S00°E	16.86'

See sketch reverse side-corner "D"


P.A. 345 1990 KENT COUNTY
PEER APPROVED 3/24/94
CHAIRMAN *Harry Hubert*

C. Description of monument for corner and accessories established to perpetuate locating the position of the corner:

H-10 Replaced 3/4" Iron Pipe with Standard Kent County Monument


Set Nail & KC Remon. tag N. side 15" Cherry	S70°W	33.85'
Set Nail & KC Remon. tag N. side 20" Maple	S90°W	24.62'
Set Nail & KC Remon. tag S. side 24" Oak	S85°E	11.37'
Set Nail & KC Remon. tag E. side 16" Oak	S00°E	16.86'
Set Nail & KC Remon. tag N. side 24" Oak	S50°E	19.00'

On E-W fence

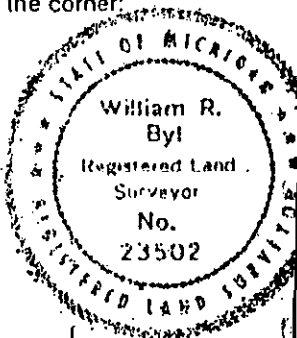

Signed by *W. R. Byl*
Surveyor's Michigan License No. 23502

Date 06-17-94

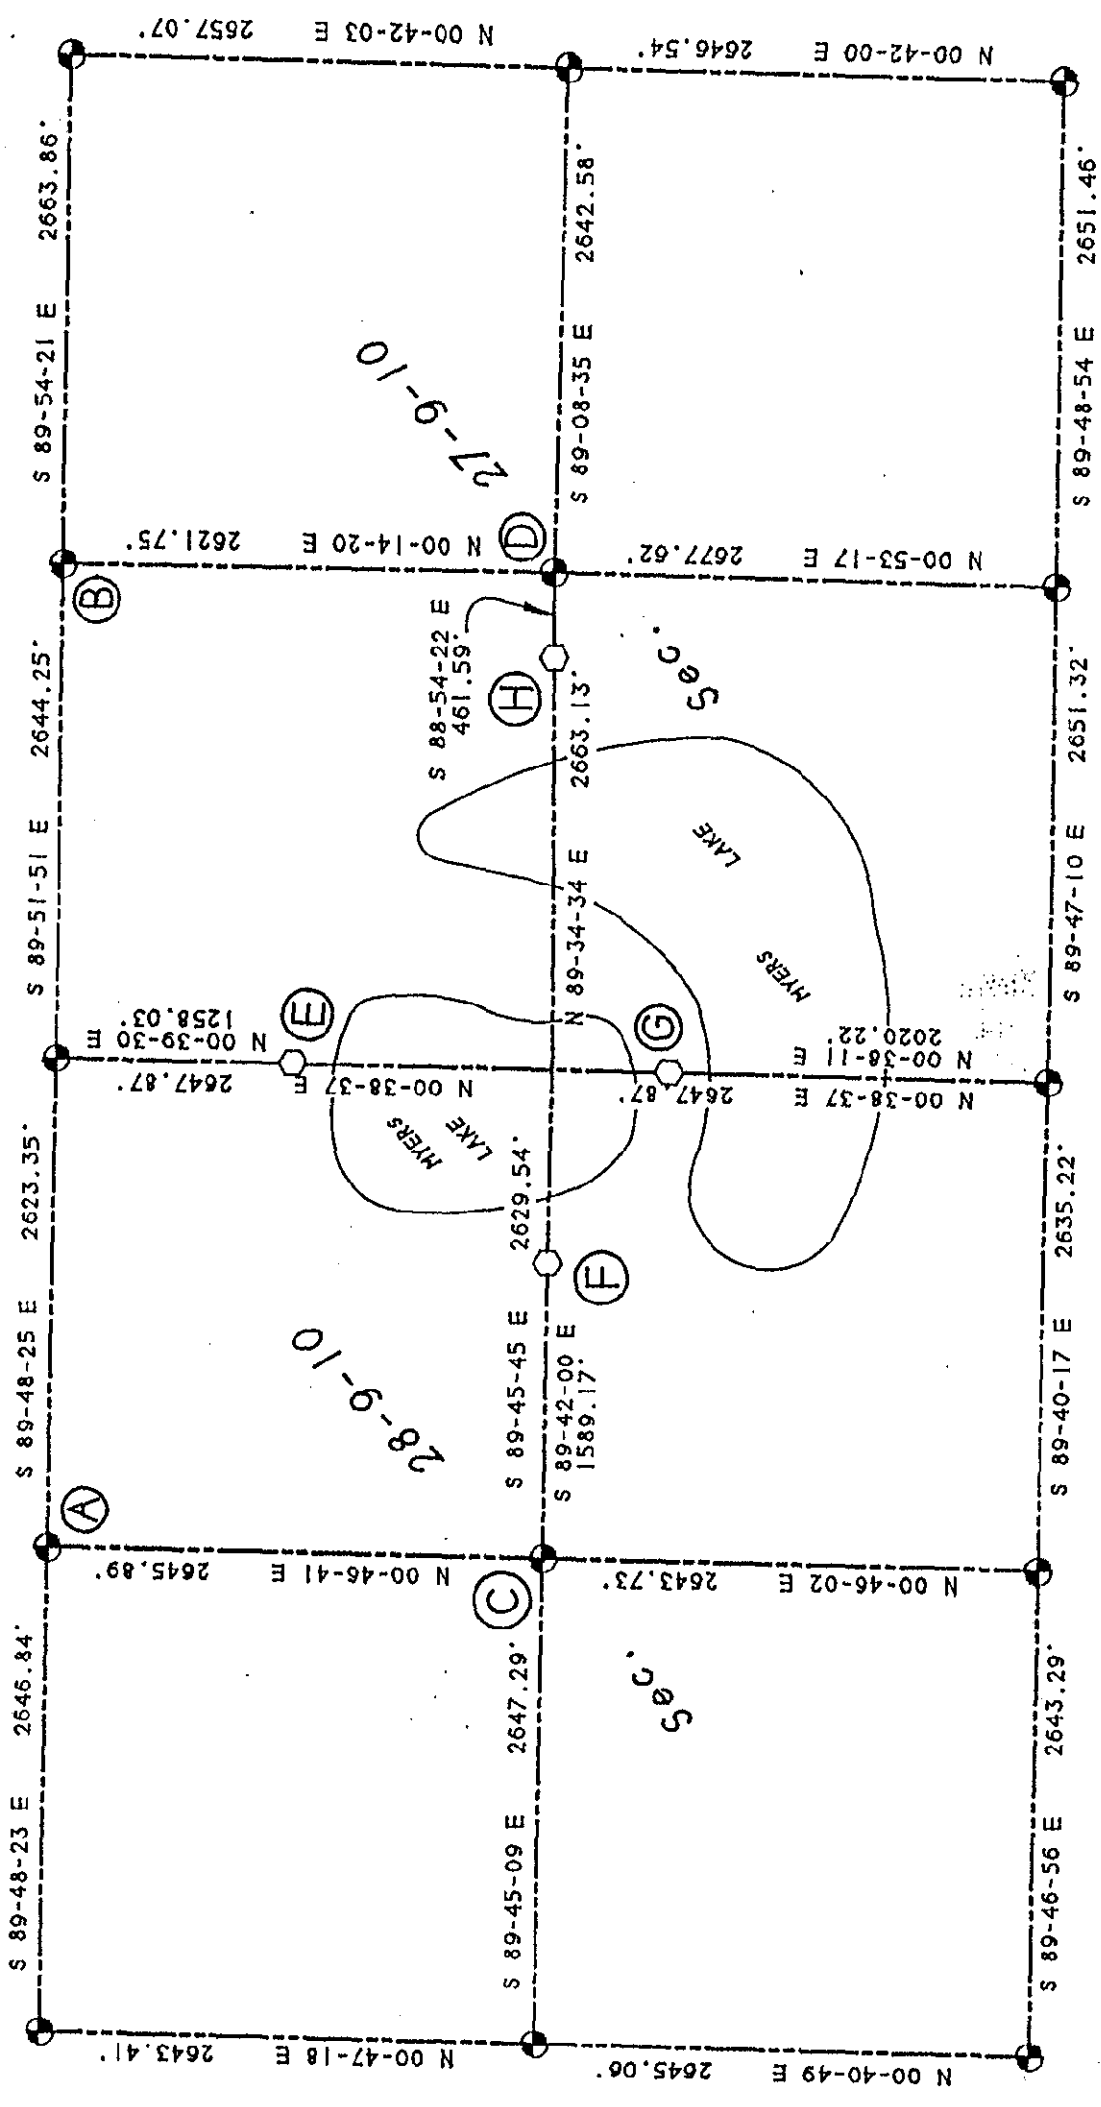

SECTION 27 & 28, TOWN 9 NORTH, RANGE 10 WEST
 COURTLAND TWP., KENT COUNTY, MICHIGAN.



PREPARED BY:
 WILLIAM R. BYL, INC.
 REGISTERED LAND SURVEYORS
 1549 KALAMAZOO SE
 GRAND RAPIDS, MI. 49507

SCALE: 1" = 1000'

- - KENT COUNTY MONUMENT
 - - KENT COUNTY REFERENCE MONUMENT
- BEARING DATUM PER SOLAR OBSERVATION