

112

MAY 22 2000

SECTION

LAND CORNER RECORDATION CERTIFICATE
Filing Requirement of Act 74, Mich. P.A. 1970
KENT COUNTY REMONUMENTATION

For corners in

Kent (County)	Located in: Courtland Township	Corner Code #
1. Public Land Survey	T <u>9N</u> R <u>10W</u>	<u>H-11</u>
	T _____ R _____	_____
	T _____ R _____	_____
	T _____ R _____	_____
2. Property Controlling in Section	S _____ T _____ R _____	_____
	S _____ T _____ R _____	_____
3. Miscellaneous Property in Sec.	S _____ T _____ R _____	_____
	S _____ T _____ R _____	_____

REG. OF DEEDS

[Signature]

STATE OF MICHIGAN
COUNTY OF KENT
RECEIVED FOR RECORD
1999 OCT 15 AM 8:05

11335

Register of Deeds Stamp & File Number


4. Lot No. _____, Recorded Plat _____
5. Private Claims _____

I, Randy Kolehouse, in a field survey on January 5 19 99, do hereby certify that under requirements of P.A. 74 Michigan P.A. of 1970, the corner points mentioned in lines 1 and 2 above were in conformance with regulations and rules therefore as required in the current manual of survey instructions of the United States Department of the interior, Bureau of Land Management or by a decree of a Court of Law and/or that the corner points mentioned in lines 3, 4 and 5 above were in conformance with the rules of the Michigan Board of Land Surveyors or by a Decree of a Court of Law; established, re-established, monumented, re-monumented, recovered, found as expressed below:

NOTE: Not more than 4 corners, all in the same town and range, may be recorded on this certificate.

A. Description of original monument and accessories and/or subsequent restoration:

H-11	1837	G.L.O. Notes	Cathcart	Set Post
	N/A	Witness Map	K.C. Surveyor	Iron in Mon. Box
	1972	L.C.R.C. #223	Williams & Works	1" Iron in Mon. Box
	1982	L.C.R.C. #3054	Jonker Land Survey	Fnd. 3/4" Iron in Mon. Box / Set K.C. Monument
	1991	L.C.R.C. #6258	C. Marschall	K.C. Monument

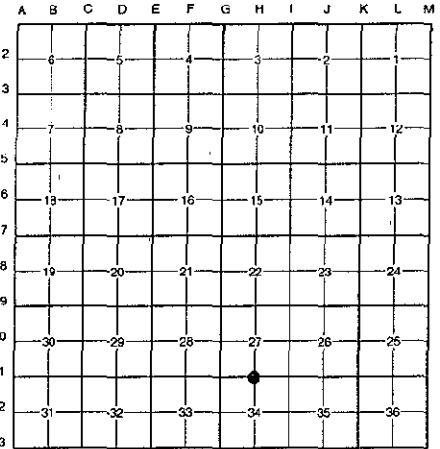

This corner was originally approved by the Kent County Remonumentation Peer Group and monumented by Rob Jonker on 7/29/82 and was recorded per L.C.R.C. #3054.

B. Description of corner evidence found and/or method applied in restoring or reestablishing corner:

H-11 Found a Standard Kent County Monument 1.5' South of the C/L of 11 Mile Road (bit.) running East and West, on line of a tree row running North and South, per L.C.R.C.'s #3054 and #6258 as set by Rob Jonker in place of a 3/4" iron he found in a monument box which checked L.C.R.C. #223 and the K.C. Surveyor's records.

L.C.R.C. #3054

L.C.R.C. #6258

Remon. tag on N side 24" Hickory S70°E 78.28'
Remon. tag on W side p.pole S05°W 59.42'
Remon. tag on N side 36" Oak S80°W 99.98;
C/L top concrete post N40°E 37.0'

Nail & Tag N sd. 26" Hickory S 70 E 78.28' (m. 78.13')
Nail & Tag W sd. P. Pole S 05 W 59.37' (m. 59.41')
Nail & Tag N sd. 38" Oak S 80 W 99.91' (m. 99.87')
Centerline top conc. post N 40 E 36.97' (m. 36.99')

The selected location is accepted by me and is generally accepted by professional surveyors as the best available evidence of the position of the original corner.

C. Description of monument for corner and accessories established to perpetuate locating the position of the corner:


H-11 Standard Kent County Monument

Nail & K.C. remon. tag on N side 28" Hickory S 70° E 78.13'
Nail & K.C. remon. tag on W side P. pole S 05° W 59.41'
Nail & K.C. remon. tag on W side 40" Oak S 80° W 99.87'
C/L top conc. post N 40° E 36.99'
C/L of bit. road running E-W, North 1.5'
On tree row running N-S

P.A. 345 1990 KENT COUNTY

PEER APPROVED: 2/25/99

CHAIRMAN Randy Kolehouse

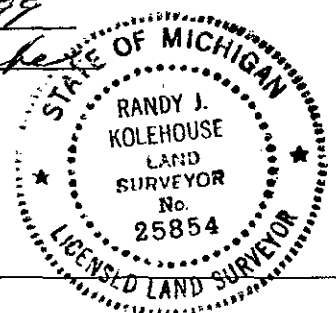

Signed by Randy J. Kolehouse
EARTH TECH

Date 3/30/99

Surveyor's Michigan License No. 25854