

SURVEY & REMONUMENTATION

MAR 03 1998

\$7.00
\$2.00

SECTION _____

LAND CORNER RECORDATION CERTIFICATE
Filing Requirement of Act 74, Mich. P.A. 1970
KENT COUNTY REMONUMENTATION

For corners in

Kent (County)	Located in:	Courtland Township	Corner Code #
1. Public Land Survey	T <u>9N</u>	R <u>10W</u>	<u>H-13</u>
	T _____	R _____	_____
	T _____	R _____	_____
	T _____	R _____	_____
2. Property Controlling in Section	S _____	T _____	R _____
	S _____	T _____	R _____
3. Miscellaneous Property in Sec.	S _____	T _____	R _____
	S _____	T _____	R _____
4. Lot No. _____, Recorded Plat _____			
5. Private Claims _____			

STATE OF MICHIGAN
COUNTY OF KENT
RECEIVED FOR RECORD
97 NOV 14 AM 9:01
REG. OF DEEDS
Tracy Bond

10325

Register of Deeds Stamp & File Number

I, Randy Kolehouse, in a field survey on July 14 19 97, do hereby certify that under requirements of P.A. 74 Michigan P.A. of 1970, the corner points mentioned in lines 1 and 2 above were in conformance with regulations and rules therefore as required in the current manual of survey instructions of the United States Department of the Interior, Bureau of Land Management or by a decree of a Court of Law and/or that the corner points mentioned in lines 3, 4 and 5 above were in conformance with the rules of the Michigan Board of Land Surveyors or by a Decree of a Court of Law; established, re-established, monumented, re-monumented, recovered, found as expressed below:

NOTE: Not more than 4 corners, all in the same town and range, may be recorded on this certificate.

A. Description of original monument and accessories and/or subsequent restoration:

H-13	1831	G.L.O. Notes	Mullett	Set Post
	1944	Witness Map	K.C. Surveyor	Monument Box
	1978	L.C.R.C. #1107	Exxel Engineering	Bolt Spike
	1981	L.C.R.C. #1758	Williams & Works	Fnd. Bt. Spike / Set K.C. Monument
	1992	L.C.R.C. #6256	Chris Marschall	K.C. Monument

Note: This corner is not common with H-1, T8N, R10W.

This corner was originally approved by the Kent County Remonumentation Peer Group and monumented by Williams & Works on 1/19/81 and was recorded per L.C.R.C. #1758.

B. Description of corner evidence found and/or method applied in restoring or reestablishing corner:

H-13 Found a Standard Kent County Monument in a monument box 1' North of the C/L of 10 Mile Road (bit.) running East and West per L.C.R.C.'s #1758 and #6256 as set by Williams & Works in place of a boat spike they found over a 1-1/2" iron which checked L.C.R.C. #1107 and the K.C. Surveyor's records.

L.C.R.C. #1758

L.C.R.C. #6256

Nail & K.C. Remon. Tag in NE Side 14" Oak N 50°W 40.96'
Nail & K.C. Remon. Tag in SW Side 18" Oak N 60°W 63.84'
Nail & K.C. Remon. Tag in SW Side P. Pole S 70°E 108.02'
Nail & K.C. Remon. Tag in S. Side Twin 16" Oak N 70°E 102.37'


Nail & Tag E sd. 26" Oak N 23 W 44.79'
Nail & Tag NE sd. 20" Oak N 47 W 40.90'
Nail & Tag SE sd. 28" Oak S 59 W 70.55'
Nail & Tag S sd. 26" Oak N 75 E 102.23'
Nail & Tag NE sd. Twin 10" Maple S 25 E 33.99'
Mon H-1 8N 10W N 90 E 122.13'

The selected location is accepted by me and is generally accepted by professional surveyors as the best available evidence of the position of the original corner.

C. Description of monument for corner and accessories established to perpetuate locating the position of the land corner:

H-13 Standard Kent County Monument in a Monument Box

Nail & K.C. remon. tag on E side 26" Oak N 23° W 44.79'
Nail & K.C. remon. tag on NE side 20" Oak N 47° W 40.90'
Nail & K.C. remon. tag on SE side 28" Oak S 59° W 70.55'
Nail & K.C. remon. tag on S side 26" Oak N 75° E 102.23'
K.C. Mon., H-1, T8N, R10W, East 122.13'

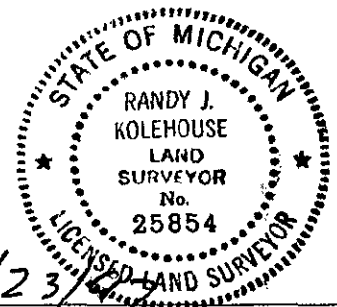

Signed by *Randy J. Kolehouse*
EARTH TECH

Date 9/23/97

Surveyor's Michigan License No. 25854

