

MAY 22 2000

1/2

SECTION

LAND CORNER RECORDATION CERTIFICATE
Filing Requirement of Act 74, Mich. P.A. 1970
KENT COUNTY REMONUMENTATION

REG. OF DEEDS

[Signature]

STATE OF MICHIGAN
COUNTY OF KENT
RECEIVED FOR RECORD
1999 OCT 15 AM 8:05

For corners in


Table with columns: Kent (County), Located in: Courtland Township, Corner Code #. Rows include Public Land Survey, Property Controlling in Section, and Miscellaneous Property in Sec.

11336

Register of Deeds Stamp & File Number

- 4. Lot No.
5. Private Claims

I, Randy Kolehouse, in a field survey on February 16, 1999, do hereby certify that under requirements of P.A. 74 Michigan P.A. of 1970, the corner points mentioned in lines 1 and 2 above were in conformance with regulations and rules therefore as required in the current manual of survey instructions of the United States Department of the interior, Bureau of Land Management or by a decree of a Court of Law and/or that the corner points mentioned in lines 3, 4 and 5 above were in conformance with the rules of the Michigan Board of Land Surveyors or by a Decree of a Court of Law; established, re-established, monumented, re-monumented, recovered, found as expressed below:

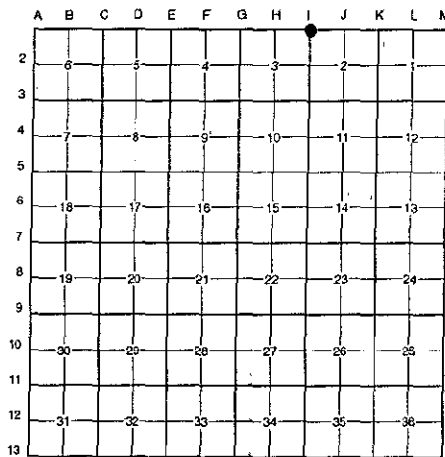

NOTE: Not more than 4 corners, all in the same town and range, may be recorded on this certificate.

A. Description of original monument and accessories and/or subsequent restoration:

Table with 4 columns: Corner Code, Date, Description, and Monument Type. Includes entries for 1837, 1898, 1967, and 1986.

Note: This corner is not common with I-13, T10N, R10W.

This corner was originally approved by the Kent County Remonumentation Peer Group and monumented by Randy Kolehouse in May of 1986 and was recorded per L.C.R.C. #4439.

B. Description of corner evidence found and/or method applied in restoring or reestablishing corner:

I-1 Found a Standard Kent County Monument 6.0' North of the C/L of 16 Mile Road (gravel) running East and West and 112.5' East of the C/L of Pine Lake Avenue (bit.) running North and South per L.C.R.C. #4439 as set by Randy Kolehouse in place of a 1" iron he found on the Township line which checks with the 1898 and 1967 notes of Williams & Works.

L.C.R.C. #4439

- Nail & K.C. Remon. tag in SW side 12" Oak N 65° W 33.92' (m. 33.83')
Nail & K.C. Remon. tag in E. side 10" W. Cherry N 25° E 21.28' (m. 21.14')
Nail & K.C. Remon. tag in SE side 40" Oak N 65° E 38.65'
Nail & K.C. Remon. tag in W. side 12" W. Cherry S 30° E 45.62' (m. 45.68')
K.C. Mon. at SE cor. sec. 34 T10N R10W West 217.5' (m. 217.33')
C/L 16 Mile Road (gravel) South 6'

P.A. 345 1990 KENT COUNTY
PEER APPROVED 10/25/99
CHAIRMAN [Signature]

The selected location is accepted by me and is generally accepted by professional surveyors as the best available evidence of the position of the original corner.

C. Description of monument for corner and accessories established to perpetuate locating the position of the corner:

I-1 Standard Kent County Monument

- Nail & K.C. remon. tag on SW side 12" Oak N 65° W 33.83'
Nail & K.C. remon. tag on E side 10" W. Cherry N 10° W 21.14'
Nail & K.C. remon. tag on S side 40" Oak N 65° E 38.65'
Nail & K.C. remon. tag on W side 12" W. Chrery S 30° E 45.68'
C/L of gravel road running E-W, South 6.0'
C/L of bit. road running N-S, West 112.5'
K.C. Mon., I-13, T10N, R10W, West 217.33'

Signed by [Signature] EARTH TECH

Date 3/30/99

Surveyor's Michigan License No. 25854

