

MAY 22 2000

SECTION

LAND CORNER RECORDATION CERTIFICATE
Filing Requirement of Act 74, Mich. P.A. 1970
KENT COUNTY REMONUMENTATION

For corners in

Table with columns: Kent (County), Located in: Courtland Township, Corner Code #. Rows include Public Land Survey, Property Controlling in Section, and Miscellaneous Property in Sec.

REG. OF DEEDS stamp with date 1999 OCT 15 AM 8:05 and file number 11337.

- 4. Lot No.
5. Private Claims


I, Randy Kolehouse, in a field survey on February 15, 1999, do hereby certify that under requirements of P.A. 74 Michigan P.A. of 1970, the corner points mentioned in lines 1 and 2 above were in conformance with regulations and rules therefore as required in the current manual of survey instructions of the United States Department of the Interior, Bureau of Land Management or by a decree of a Court of Law and/or that the corner points mentioned in lines 3, 4 and 5 above were in conformance with the rules of the Michigan Board of Land Surveyors or by a Decree of a Court of Law; established, re-established, monumented, re-monumented, recovered, found as expressed below:

NOTE: Not more than 4 corners, all in the same town and range, may be recorded on this certificate.

A. Description of original monument and accessories and/or subsequent restoration:

Table with columns: Date (1837-1991), Description (G.L.O. Notes, Witness Map, L.C.R.C. #3419, #3635, #6254), Name (Cathcart, K.C. Surveyor, Glaza & Associates, John Bueche, C. Marshall), and Monument Type (Set Post, Iron & Monument, Monument Box, Fnd. 1" Iron / Set K.C. Monument Over Conc. Mop., K.C. Monument).

P.A. 345 1990 KENT COUNTY PEER APPROVED 2/25/99 CHAIRMAN [Signature]

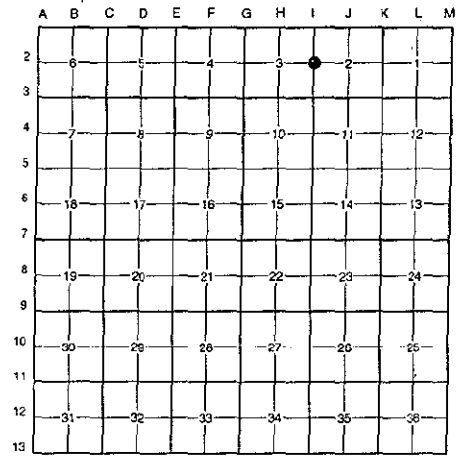

This corner was originally approved by the Kent County Remonumentation Peer Group and monumented by John Bueche on 11/14/83 and was recorded per L.C.R.C. #3635.

B. Description of corner evidence found and/or method applied in restoring or reestablishing corner:

Found a Standard Kent County Monument in a monument box on the C/L intersection of Pine Lake Avenue (bit.) running North and South and Benham Street (bit.) running East, on line of a tree row running West, per L.C.R.C.'s #3635 and #6254 as set by John Bueche in place of a 1" x 15" iron he found on top of a small boat spike on top of a concrete monument in a monument box which checked L.C.R.C. #3419 and the K.C. Surveyor's records.

L.C.R.C. #3635

L.C.R.C. #6254

K.C. Remon. tag & nail in S side of 14" Hickory N 90° W 27.23'
K.C. Remon. tag & nail in E side of 38" maple S 30° W 91.34'
K.C. Remon. tag & nail in E side of 36" Maple S 15° W 134.13'
On C/L blacktop road N - S
On C/L blacktop road East
Fence & tree row West

Nail & Tag S side 16" Hickory N 90 W 27.21'
Nail & Tag E side 42" Maple S 15 W 134.06'
Nail & Tag E side 44" Maple S 30 W 91.26'
Nail & Tag E side 8" Twin Cherry S 40 W 60.76' (m. 61.81)'
Nail & Tag S side 12" Maple N 80 W 30.47' (m. 30.39')

The selected location is accepted by me and is generally accepted by professional surveyors as the best available evidence of the position of the original corner.

C. Description of monument for corner and accessories established to perpetuate locating the position of the corner:

Standard Kent County Monument in a Monument Box

Nail & K.C. remon. tag on E side 42" Maple S 15° W 134.06'
Nail & K.C. remon. tag on E side 44" Maple S 30° W 91.26'
Nail & K.C. remon. tag on E side 10" Cherry S 40° W 61.81'
Nail & K.C. remon. tag on S side 12" Maple N 80° W 30.39'
Nail & K.C. remon. tag on S side 16" Hickory N 90° W 27.21'

On C/L "X" of bit. roads running N-S-E
On tree row running W

Signed by [Signature] EARTH TECH

Date 3/30/99

Surveyor's Michigan License No. 25854

