

MAY 22 2000

SECTION

LAND CORNER RECORDATION CERTIFICATE
Filing Requirement of Act 74, Mich. P.A. 1970
KENT COUNTY REMONUMENTATION

For corners in

Table with columns: Kent (County), Located in: Courtland Township, Corner Code #. Rows include Public Land Survey, Property Controlling in Section, and Miscellaneous Property in Sec.

Register of Deeds Stamp & File Number 11339. Includes vertical stamp: STATE OF MICHIGAN COUNTY OF KENT RECEIVED FOR RECORD 1999 OCT 15 AM 8:05 and REG. OF DEEDS.

4. Lot No. , Recorded Plat
5. Private Claims

I, Randy Kolehouse, in a field survey on February 15 19 99, do hereby certify that under requirements of P.A. 74 Michigan P.A. of 1970, the corner points mentioned in lines 1 and 2 above were in conformance with regulations and rules therefore as required in the current manual of survey instructions of the United States Department of the interior, Bureau of Land Management or by a decree of a Court of Law and/or that the corner points mentioned in lines 3, 4 and 5 above were in conformance with the rules of the Michigan Board of Land Surveyors or by a Decree of a Court of Law; established, re-established, monumented, re-monumented, recovered, found as expressed below:

NOTE: Not more than 4 corners, all in the same town and range, may be recorded on this certificate.

A. Description of original monument and accessories and/or subsequent restoration:

Table with 4 columns: Year (1837, N/A, 1973, 1982, 1991), Description (G.L.O. Notes, Witness Map, L.C.R.C. #516, #3053, #6252), Name (Cathcart, K.C. Surveyor, Exxel Engineering, Jonker Land Survey, C. Marschall), and Monument Type (Set Post, Stake & Stone, 3/4" Iron, Fnd. 3/4" Iron Pipe / Set K.C. Monument, K.C. Monument).

P.A. 345 1990 KENT COUNTY PEER APPROVED 2/25/99 CHAIRMAN Harry Huber

This corner was originally approved by the Kent County Remonumentation Peer Group and monumented by Rob Jonker on 7/29/82 and was recorded per L.C.R.C. #3053.

B. Description of corner evidence found and/or method applied in restoring or reestablishing corner:

I-4 Found a Standard Kent County Monument 10' South of the C/L of Swift Street (gravel) running East and 10' West of the C/L of Farland Avenue (gravel) running South per L.C.R.C.'s #3053 and #6252 as set by Rob Jonker in place of a 3/4" iron pipe he found at grade over a 4" diameter stone 24" below grade which checked L.C.R.C. #516 and the K.C. Surveyor's records.

L.C.R.C. #3053

L.C.R.C. #6252

Remon. tag on SW side 9" Ash S40°E 90.60' In line with W edge of gravel to S & S edge of gravel to East


Nail & Remon Tag | N sd. 16" Maple 3' High N 71 E 82.96' (m. 82.97') Nail & Remon Tag in SW sd. 10" Ash 3' high S 46 E 90.51' Nail & Remon Tag in S sd. 28" Oak West 104.26' (m. 104.18') In line with W edge of gravel to S & S edge of gravel to East

The selected location is accepted by me and is generally accepted by professional surveyors as the best available evidence of the position of the original corner.

C. Description of monument for corner and accessories established to perpetuate locating the position of the corner:

I-4 Standard Kent County Monument

- Nail & K.C. remon. tag on N side 16" Maple (3' up) N 71° E 82.97'
Nail & K.C. remon. tag on SW side 12" Ash (3' up) S 46° E 90.51'
Nail & K.C. remon. tag on S side 30" Oak West 104.18'
Nail & K.C. remon. tag on E side 16" Pine N 35° W 58.86'
C/L of gravel road running E, North 10'
C/L of gravel road running S, East 10'

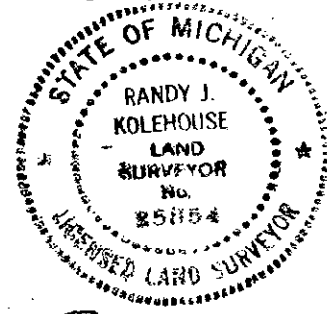

Signed by Randy J. Kolehouse WILLIAMS & WORKS

Date 9.27.99

Surveyor's Michigan License No. 25854