

11/2

MAY 22 2000

SECTION

LAND CORNER RECORDATION CERTIFICATE
Filing Requirement of Act 74, Mich. P.A. 1970
KENT COUNTY REMONUMENTATION

For corners in

Kent (County)	Located in: Courtland Township	Corner Code #
1. Public Land Survey	T <u>9N</u> R <u>10W</u>	<u>1-5</u>
	T _____ R _____	_____
	T _____ R _____	_____
	T _____ R _____	_____
2. Property Controlling in Section	S _____ T _____ R _____	_____
	S _____ T _____ R _____	_____
3. Miscellaneous Property in Sec.	S _____ T _____ R _____	_____
	S _____ T _____ R _____	_____

REG. OF DEEDS

[Signature]

STATE OF MICHIGAN
COUNTY OF KENT
RECEIVED FOR RECORD
1999 OCT 15 AM 8:06


11340

Register of Deeds Stamp & File Number

4. Lot No. _____, Recorded Plat _____
5. Private Claims _____

I, Randy Kolehouse, in a field survey on February 1 19 99, do hereby certify that under requirements of P.A. 74 Michigan P.A. of 1970, the corner points mentioned in lines 1 and 2 above were in conformance with regulations and rules therefore as required in the current manual of survey instructions of the United States Department of the Interior, Bureau of Land Management or by a decree of a Court of Law and/or that the corner points mentioned in lines 3, 4 and 5 above were in conformance with the rules of the Michigan Board of Land Surveyors or by a Decree of a Court of Law; established, re-established, monumented, re-monumented, recovered, found as expressed below:

NOTE: Not more than 4 corners, all in the same town and range, may be recorded on this certificate.

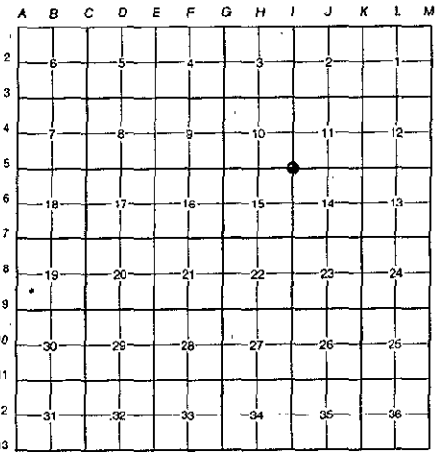

A. Description of original monument and accessories and/or subsequent restoration:

I-5	1837	G.L.O. Notes	Cathcart	Set Post	P.A. 345 1990 KENT COUNTY PEER APPROVED <u>2/25/99</u> CHAIRMAN <u>[Signature]</u>
	1963	Witness Map	K.C. Surveyor	Bridge Spike	
	1973	L.C.R.C. #516	Exxel Engineering	Boat Spike	
	1980	L.C.R.C. #1395	Moore & Bruggink	Iron	
	1982	L.C.R.C. #3052	Jonker Land Survey	Fnd. Boat Spike / Set K.C. Monument in Mon. Box	
	1991	L.C.R.C. #6251	C. Marschall	K.C. Monument	

This corner was originally approved by the Kent County Remonumentation Peer Group and monumented by Rob Jonker on 7/29/82 and was recorded per L.C.R.C. #3052.

B. Description of corner evidence found and/or method applied in restoring or reestablishing corner:

I-5 Monument had been removed. Found a PK nail 14.3' North of the C/L of 14 Mile Road (M-57) (bit.) running East and West and the C/L of Farland/Pine Lake Avenue (gravel) running North, on line of a fence line and tree row running South. PK nail checks witnesses from L.C.R.C.'s #516, #3052 and #6251.

L.C.R.C. #3052

L.C.R.C. #6251

Remon. tag on W side 10" Hickory S10°E 87.37'
On C/L to N & fence & tree line to South
C/L E-W pvt. S. 14.33'

Nail & Tag W sd. 12" Hickory (3' above grd.) S 16 E 87.44' (m. 87.50')
Chiseled "X" conc. end section 15" culv. N 80 E 167.66'
Centerline E & W pvt. S 14.33'
Nail & Tag E sd. 10" Pine (5' above ground) S 27 W 101.92' (m. 101.95')
Top center of STEEL fence post N 11 E 166.99' (m. 166.84')
Top center of STEEL fence post N 73 W 195.40' (m. 195.36')

The selected location is accepted by me and is generally accepted by professional surveyors as the best available evidence of the position of the original corner.

C. Description of monument for corner and accessories established to perpetuate locating the position of the corner:

I-5 Replaced PK Nail with a Standard Kent County Monument

Nail & K.C. remon. tag on W side 12" Hickory (3' above grd.) S 16° E 87.50'
Nail & K.C. remon. tag on E side 11" Pine (5' above grd.) S 27° W 101.95'
Chiseled "X" conc. end section 15" culv. N 80° E 167.66'
Top C/L fence post N 11° E 166.84'
Top C/L fence post N 73° W 195.36'

C/L of bit. road running E-W, South 14.3'
On C/L of gravel road running N
On fence line and tree row running S

Signed by Randy J. Kolehouse
EARTH TECH

Date 3/30/99

Surveyor's Michigan License No. 25854

