

MAY 22 2000

1/2

SECTION

LAND CORNER RECORDATION CERTIFICATE
Filing Requirement of Act 74, Mich. P.A. 1970
KENT COUNTY REMONUMENTATION

For corners in

Table with columns: Kent (County), Located in: Courtland Township, Corner Code #. Rows include Public Land Survey, Property Controlling in Section, and Miscellaneous Property in Sec.

REG. OF DEEDS

Handwritten signature/initials


STATE OF MICHIGAN
COUNTY OF KENT
RECEIVED FOR RECORD
1999 OCT 15 AM 8:06

11342

Register of Deeds Stamp & File Number

4. Lot No. , Recorded Plat
5. Private Claims

I, Randy Kolehouse, in a field survey on January 15 19 99, do hereby certify that under requirements of P.A. 74 Michigan P.A. of 1970, the corner points mentioned in lines 1 and 2 above were in conformance with regulations and rules therefore as required in the current manual of survey instructions of the United States Department of the Interior, Bureau of Land Management or by a decree of a Court of Law and/or that the corner points mentioned in lines 3, 4 and 5 above were in conformance with the rules of the Michigan Board of Land Surveyors or by a Decree of a Court of Law; established, re-established, monumented, re-monumented, recovered, found as expressed below:

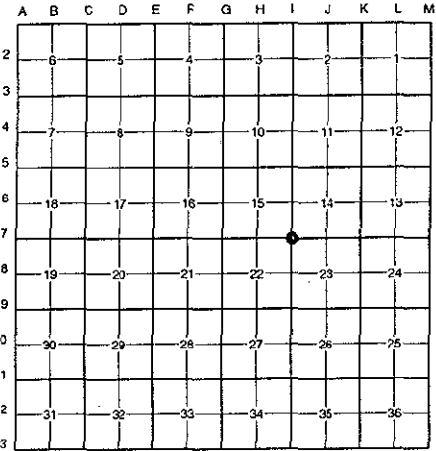

NOTE: Not more than 4 corners, all in the same town and range, may be recorded on this certificate.

A. Description of original monument and accessories and/or subsequent restoration:

Table with 4 columns: Corner Code, Date, Description, and Monument Type. Rows include 1837 G.L.O. Notes Cathcart Set Post, 1983 L.C.R.C. #3595 William Byl Fnd. PK Nail / Set K.C. Monument, and 1991 L.C.R.C. #6250 C. Marschall K.C. Monument.

This corner was originally approved by the Kent County Remonumentation Peer Group and monumented by William Byl on 9/1/83 and was recorded per L.C.R.C. #3595.

B. Description of corner evidence found and/or method applied in restoring or reestablishing corner:

I-7 Found a Standard Kent County Monument at the C/L intersection of 13 Mile Road (bit.) running East and West and Young Avenue (gravel) running South per L.C.R.C.'s #3595 and #6250 as set by William Byl in place of a found PK nail.

L.C.R.C. #3595

L.C.R.C. #6250

Nail & tag, W sd. 30" Maple N 00 E 28.62'
Nail & tag, E sd. 30" Oak S 15 E 89.26'
Nail & tag, N sd. MBT Pole S 60 E 58.75'
Nail & tag, W sd. Power pole S 30 W 137.20'

Nail & Remon tag in E side 40" Oak S 19 E 84.25' (m. 84.83')
Nail & Remon tag in W side 34" Maple N 0 E 28.61' (m. 28.65')
Nail & Remon tag in N side Tel Pole S 67 E 58.75' (m. 58.77')
Nail & Remon tag in W side Power Pole S 28 W 137.14' (m. 137.21)'

The selected location is accepted by me and is generally accepted by professional surveyors as the best available evidence of the position of the original corner.

C. Description of monument for corner and accessories established to perpetuate locating the position of the corner:

I-7 Standard Kent County Monument

Nail & K.C. remon. tag on W side 38" Maple N 00° E 28.65'
Nail & K.C. remon. tag on S side 48" Maple N 70° E 126.60'
Nail & K.C. remon. tag on N side Telephone pole S 67° E 58.77'
Nail & K.C. remon. tag on E side 44" Oak S 19° E 84.83'
Nail & K.C. remon. tag on NW side P. pole S 28° W 137.21'
On C/L "X" of bit. road running E-W and a gravel road running S

P.A. 345 1990 KENT COUNTY

PEER APPROVED 2/25/99

CHAIRMAN

Handwritten signature of Randy Kolehouse

Signed by Randy J Kolehouse
EARTH TECH

Date 3/20/99

Surveyor's Michigan License No. 25854

